IREDELL COUNTY HEALTH DEPARTMENT

STATESVILLE 704-878-5305 (1) MOORESVILLE 704-664-5281

IMPROVEMENT PERMIT / AUTHORIZATION TO CONSTRUCT / OPERATION PERMIT / EXISTING SYSTEM INSPECTION

PERMIT# 122190 PIN# 4751-49-2428 DATE 7-9-04

OWNER OR CONTRACTOR LUV HOMES OF TROUTMAN PHONE: Business 704-528-0848 Home

ADDRESS 1036 CHARLOTTE HIGHWAY, TROUTMAN, NC 28116

LOCATION AMITY HILL ROAD SOUTH TR PILCH ROAD, TR 1 MAY JEAN DRIVE, AT END ON RIGHT

SUBDIVISION BLOCK / SECTION LOT LOT AREA 3.89 ACRES SITE CLASS. PS DESIGN FLOW 360 L.T.A.R. 0.30 GPD/FT²

Septic Tank: 1000 Gallons; STB 794 Date 6-9-04

Pump Tank: Gallons; PT Date

Pump Make: Model Serial No.

Nitrification Field: No Fields 1 Square Feet 540 Linear Feet 135

No Lines ONE Trench Width 36" Max Trench Bottom Depth 36" Gravel Depth N/A

☒ New System ☐ Repair System Type: I, II, III, IV, V, VI

System Description: 25% REDUCTION, GRAVITY

Repair System Description: 25% REDUCTION, PUMP

Maintenance Agreement Required: ☐ Yes ☒ No

☐ House/Mod. Home ☒ Mobile Home ☐ Business ☐ Other


No. Bedrooms 3 No. Bathrooms 2 No. Employees

☐ Slab ☒ Crawl Space ☐ Basement w/plumbing ☐ Basement wo/plumbing

Water Supply: ☐ Individual ☐ Public ☐ Community WELL


Comments/Conditions: (1) INSTALL NEW SEPTIC TANK AT LOCATION SHOWN (2) INSTALL NEW DROP BOX FEEDING NEW 3'X135' LINE USING 25% REDUCTION SYSTEM (3) TIE INTO ~~EXISTING DIST. BOX~~ (OR SEPTIC TANK).

INITIAL SITE SKETCH

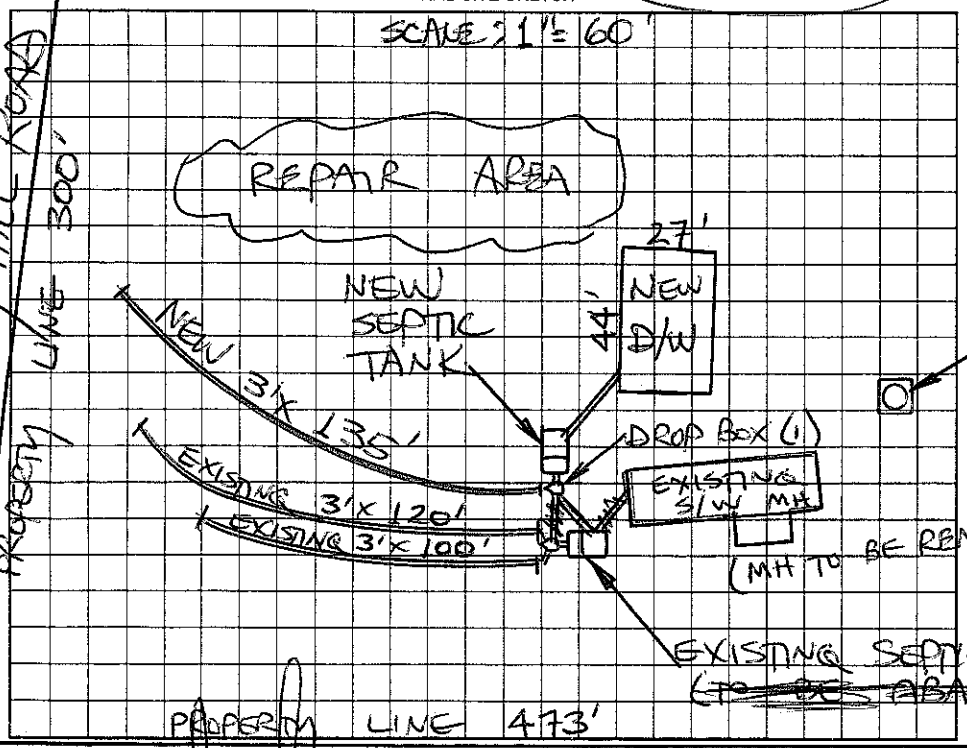

Comments/Conditions: (1) SEPTIC TANK WITH MARKER INSTALLED USING "ZABEL" FILTER, FOURTEEN HDS (2) SYSTEM EXPANDED USING 2 SECTIONS AS SHOWN.

AS BUILT SKETCH

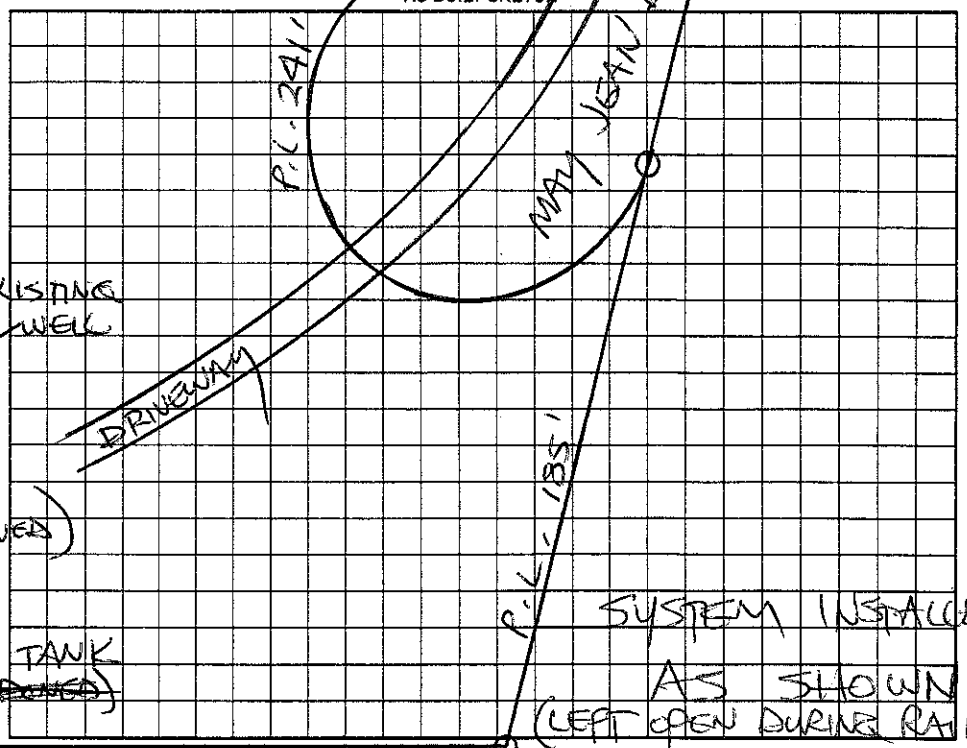

Permit can be suspended or revoked if any false information is supplied toward securing the permit/any unauthorized changes are made to the site/any unauthorized changes are made in the installation of the system. Improvement Permit with plat valid without expiration. Improvement Permit with site plan valid for sixty months. Authorization to Construct is valid for a period equal to that of Improvement Permit – not to exceed sixty months.

Signed: [signature] date 7-9-04

Improvement Permit by: STEVE HEDRICK date 7-9-04

Authorization to Construct by: STEVE HEDRICK date 7-9-04

Installed by: ANDY DANIELS

Operation Permit by: STEVE HEDRICK date ~~7-14-04~~

Existing System Inspection by: date 7-14-04

HEALTH DEPT. COPY: WHITE OWNER COPY (FINAL): YELLOW OWNER COPY (INITIAL): PINK