#63231

IREDELL COUNTY HEALTH DEPARTMENT

STATESVILLE 704-878-5305 MOORESVILLE 704-664-5281

IMPROVEMENT PERMIT / CERTIFICATE OF COMPLETION / OPERATION PERMIT / EXISTING SYSTEM INSPECTION

PROPERTY DESCRIPTION NO. 24803 DATE 9-10-96 TAX MAP NO. 5C-A-53 Watershed: ☐ Yes ☑ No

OWNER OR CONTRACTOR Doug + Tammy Pond PHONE: Business Home 872 0103

ADDRESS 107 Kimball Rd Statesville 28677

LOCATION I-77 TL Amity Hill TR Pilch Rd Turn on may Jean Drive 2nd lot

SUBDIVISION Welling Property BLOCK / SECTION LOT 1 LOT AREA 3.023 acres SITE CLASS RS DESIGN FLOW 480 L.T.A.R. .135

Septic Tank: 1000 Gallons; STB 794 Date 7-30-96

Pump Tank: Gallons; PT Date

Pump Make: Model Serial No.

Nitrification Field: No Fields 1 Square Feet 1380 Linear Feet 460

No Lines 3 Trench Width 36" Max Trench Bottom Depth 36" Gravel Depth 12"

☑ New System ☐ Repair System Type: I, II, III, IV, V, VI

System Description: Conv. Gravity

Repair System Description: Pump To Chambers

Maintenance Agreement Required: ☐ Yes ☑ No

☑ House/Mod. Home No. Bedrooms 4

☐ Mobile Home No. Bathrooms 3

☐ Business No. Employees

☐ Other


☐ Slab ☑ Crawl Space ☐ Basement w/plumbing ☐ Basement wo/plumbing

Water Supply: ☑ Individual ☐ Community ☐ Public


Comments:

Comments:

INITIAL SITE SKETCH

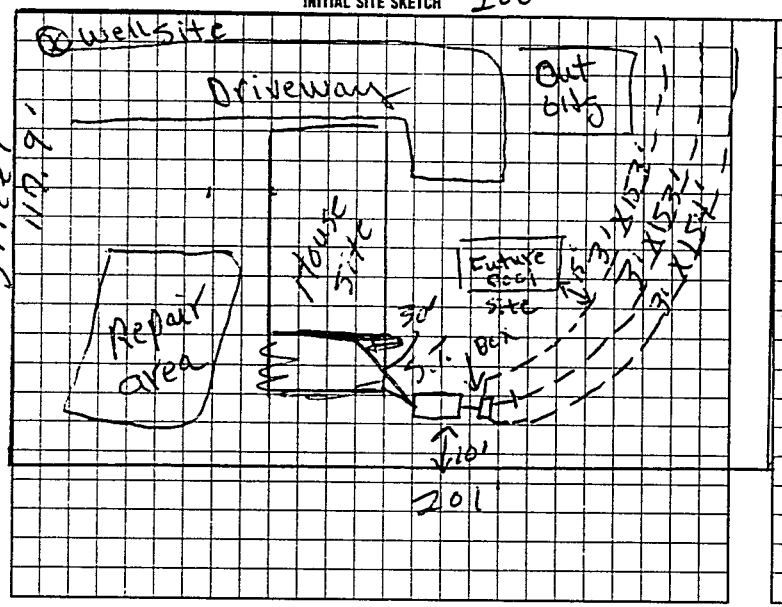

AS BUILT SKETCH

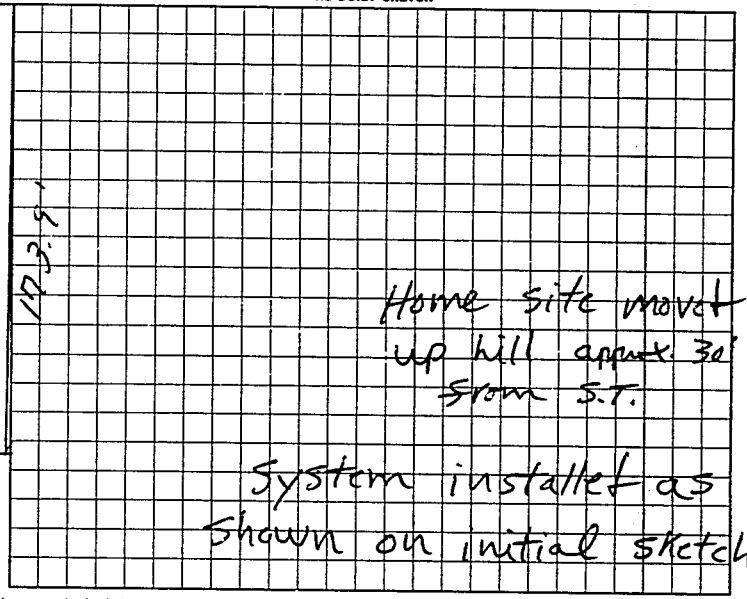

I understand that this permit can be suspended or revoked if any false information is supplied toward securing the permit/any unauthorized changes are made to the site/any unauthorized changes are made in the installation of the system.

Signed: X Jahy D Pond

Improvement Permit by: P.C. moore date 9-10-96

Existing System Inspection: P.C. moore date 9-10-96

Authorization To Const.

Installed by: T.W. Ammons

Certificate of Completion by: date

Operation Permit by: P.C. moore date 10-18-96

Authorization to Const. Expires 60 mos from issue

HEALTH DEPT. COPY: WHITE INSPECTION COPY (FINAL): GREEN OWNER COPY (FINAL): YELLOW INSPECTION COPY (INITIAL): PINK OWNER COPY (INITIAL): GOLD