IREDELL COUNTY HEALTH DEPARTMENT

STATESVILLE 704-878-5305 MOORESVILLE 704-664-5281

IMPROVEMENT PERMIT / CERTIFICATE OF COMPLETION / OPERATION PERMIT / EXISTING SYSTEM INSPECTION

PROPERTY DESCRIPTION NO. D67658 DATE 7-12-97 TAX MAP NO. 4951 49 264 Watershed: ☐ Yes ☒ No

OWNER OR CONTRACTOR Intercity Homes PHONE: Business 528-3320 Home

ADDRESS 894 S Main Street Troutman

LOCATION 77 S Exit 45 TL Amity Hill TR Pitch TR First Drive lot on R

SUBDIVISION Elsie Welling BLOCK / SECTION LOT 6 LOT AREA SITE CLASS. P/S DESIGN FLOW 480 L.T.A.R. 0.35

Septic Tank: 1000 Gallons; STB 1012 Date 6-7-97

Pump Tank: Gallons; PT Date

Pump Make: Model Serial No.

Nitrification Field: No Fields 1 Square Feet 1371 Linear Feet 457

No Lines 5 Trench Width 36 Max Trench Bottom Depth 36 Gravel Depth 12

☒ New System ☐ Repair System Type: I, II, III, IV, V, VI

System Description: Gravity Conventional

Repair System Description: 12 Chambers

Maintenance Agreement Required: ☐ Yes ☒ No

☐ House/Mod. Home ☒ Mobile Home ☐ Business ☐ Other

No. Bedrooms 3 No. Bathrooms 2 No. Employees


☐ Slab ☒ Crawl Space ☐ Basement w/plumbing ☐ Basement wo/plumbing

Water Supply: ☒ Individual ☐ Community ☐ Public


Comments: * System sized for 3 Bds

Comments:

INITIAL SITE SKETCH

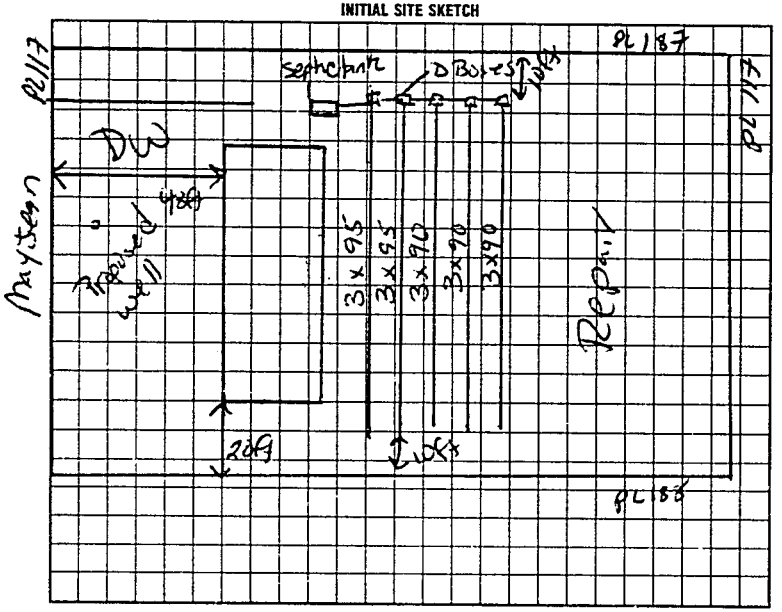

AS BUILT SKETCH

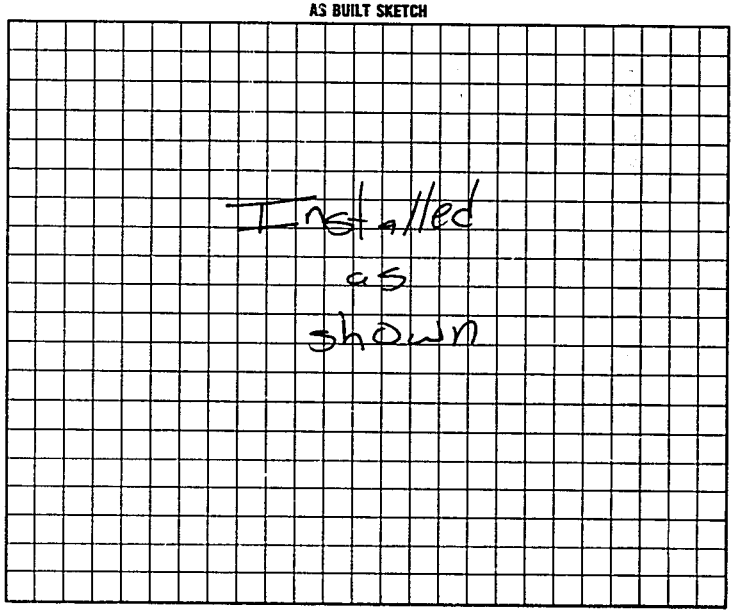

I understand that this permit can be suspended or revoked if any false information is supplied toward securing the permit/any unauthorized changes are made to the site/any unauthorized changes are made in the installation of the system. Improvement Permit is valid for 60 months from date of issuance. Authorization to construct expires 5 yrs from issue date.

Signed: Russell Silver

Improvement Permit by: Mark C Oaks date 7-12-97

Authorization to Const. Existing System Inspection by: Mark C Oaks date 7-12-97

Installed by: A-1 Backhoe

Certificate of Completion by: date

Operation Permit by: Mark C Oaks date 8-15-97

HEALTH DEPT. COPY: WHITE INSPECTION COPY (FINAL): GREEN OWNER COPY (FINAL): YELLOW INSPECTION COPY (INITIAL): PINK OWNER COPY (INITIAL): GOLD

112100