IREDELL COUNTY HEALTH DEPARTMENT

STATESVILLE 704-878-5305 MOORESVILLE 704-664-5281

IMPROVEMENT PERMIT / CERTIFICATE OF COMPLETION / OPERATION PERMIT / EXISTING SYSTEM INSPECTION

PROPERTY DESCRIPTION NO. 067665 DATE 7-12-97 TAX MAP NO. 475149 6270 Watershed: ☐ Yes ☐ No

OWNER OR CONTRACTOR Intensity Homes PHONE: Business 528-3320 Home

ADDRESS 894 S Main St Troutman NC

LOCATION 77S E to 46 TL Amity Hill TR Pitch TR First Rd 2nd lot on (R)

SUBDIVISION Elsie Welling BLOCK SECTION LOT 5 LOT AREA SITE CLASS. P/S DESIGN FLOW 480 L.T.A.R. 0.35

Septic Tank: 1000 Gallons; STB 1012 Date 6-3-97

Pump Tank. Gallons; PT Date

Pump Make: Model Serial No. 358

Nitrification Field: No Fields 1 Square Feet 1026 Linear Feet 342

No Lines 6 Trench Width 36in Max Trench Bottom Depth 36in Gravel Depth Sand

☒ New System ☐ Repair System Type: I, II, (III) IV, V, VI

System Description: Gravel Chamber

Repair System Description: Chamber/Panel

Maintenance Agreement Required: ☐ Yes ☒ No

☐ House/Mod. Home ☒ Mobile Home ☐ Business ☐ Other

No. Bedrooms 3 No. Bathrooms 2 No. Employees


☐ Slab ☒ Crawl Space ☐ Basement w/plumbing ☐ Basement wo/plumbing

Water Supply: ☒ Individual ☐ Community ☐ Public


Comments: Keep lines on contour 9ft on centr keep well max feasible distance 50ft plus Landscape yard to keep water off system.

Comments: system sized for 3 Bds

INITIAL SITE SKETCH (1 of 2)

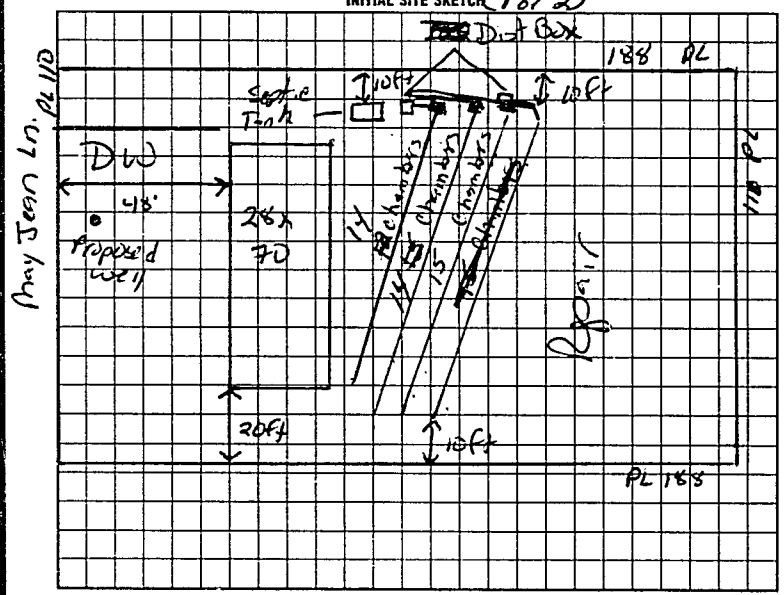

AS BUILT SKETCH

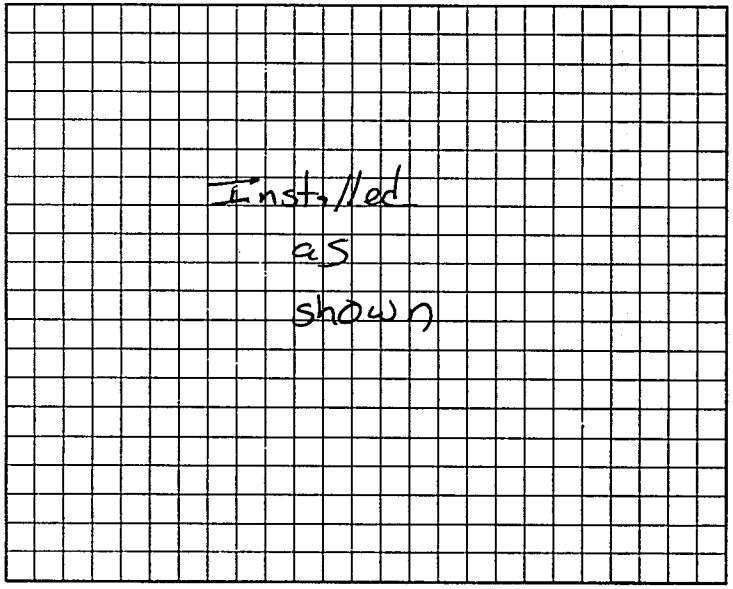

I understand that this permit can be suspended or revoked if any false information is supplied toward securing the permit/any unauthorized changes are made to the site/any unauthorized changes are made in the installation of the system. Improvement Permit is valid for 60 months from date of issuance. Authorization to construct expires 5yrs from issue date

Signed: Russell Dixon Installed by: A-1 Backhoe

Improvement Permit by: Mark Cox RS date 7-12-97 Certificate of Completion by: date

Authorization to Construct, Existing System Inspection by: Mark Cox RS date 7-12-97 Operation Permit by: Mark Cox RS date 8-8-97

HEALTH DEPT COPY WHITE INSPECTION COPY (FINAL) GREEN OWNER COPY (FINAL) YELLOW INSPECTION COPY (INITIAL) PINK OWNER COPY (INITIAL) GOLD

1 55 1 00