IREDELL COUNTY HEALTH DEPARTMENT

Statesville Phone TR 3-7271 Mooresville Phone NO 3-1271

PERMIT TO INSTALL SEPTIC TANK

Permit No. 170 Permit Date 7-10 1972

Owner Allen Edmiston Address Statesville, NC

Installed By Sam Cottrell Address Troutman, NC


Location of Property I-77 S. Turn Left on Amity Hill Rd. Go 1½ Miles. House on Left at intersection of #2366.

Tank		Capacity		Length of Lines		Fixtures	
Block	( )	1000	( )	225'	(✓)	No. of Baths	(1½)
Precast	(✓)	1250	( )	250'	( )	Dishwasher	( )
		1500	( )	Other		Garbage Grdr.	( )
		Other				Other	

NOTIFY HEALTH DEPARTMENT AT LEAST EIGHT HOURS BEFORE TANK IS TO BE INSPECTED.

Final Inspection 7-10 1972 Approved (✓) Disapproved ( )

Remarks No water supply on site at Time of Insp.

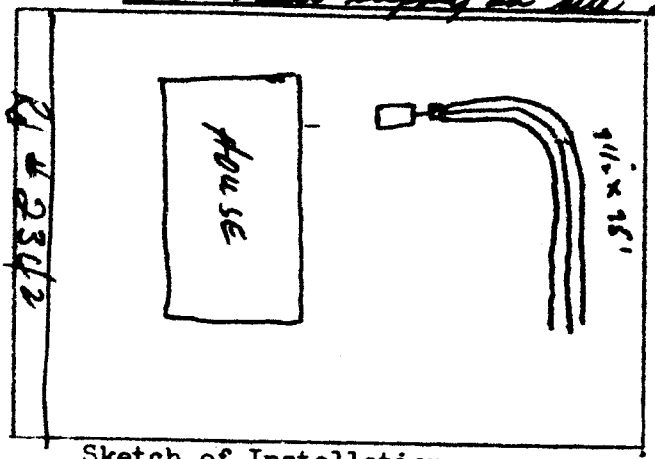

Sketch of Installation

Sanitarian