# IREDELL COUNTY HEALTH DEPARTMENT

STATESVILLE 704-878-5305 MOORESVILLE 704-664-5281

## IMPROVEMENT PERMIT / CERTIFICATE OF COMPLETION / OPERATION PERMIT / EXISTING SYSTEM INSPECTION

PROPERTY DESCRIPTION NO. 19445 DATE 10-3-94 TAX MAP NO. 5C-A-11 Watershed: ☐ Yes ☑ No

OWNER OR CONTRACTOR Oak Towne MH PHONE: Business Home 873-1481

ADDRESS 2016 N Sike Rd Statesville

LOCATION I-77 S TL Amity Hill Rd TR Pilch Rd 300' on left

SUBDIVISION Pilch Acres BLOCK / SECTION LOT 2 LOT AREA 1/2 acre SITE CLASS. 05 DESIGN FLOW 360 L.T.A.R. .3

Septic Tank: 1000 Gallons; STB [redacted]794 Date 6-29-94

Pump Tank: Gallons; PT Date

Pump Make: Model Serial No.

Nitrification Field: No Fields 1 Square Feet 1200 Linear Feet 400

No Lines 3 Trench Width 36" Max Trench Bottom Depth 36" Gravel Depth 12"

☑ New System ☐ Repair System Type: I, ☑ II, III, IV, V, VI

System Description: Conv. Gravity

Repair System Description: Perus Block Panel

Maintenance Agreement Required: ☐ Yes ☑ No

☐ House/Mod. Home ☑ Mobile Home ☐ Business ☐ Other

No. Bedrooms 3 No. Bathrooms 2 No. Employees


☐ Slab ☑ Crawl Space ☐ Basement w/plumbing ☐ Basement wo/plumbing

Water Supply: ☑ Individual ☐ Community ☐ Public

Comments:

Comments: Home and well not located at time of inspection. Keep home min. 5' from any part of septic system. Keep well min. 50' from any part of septic system.

**INITIAL SITE SKETCH**

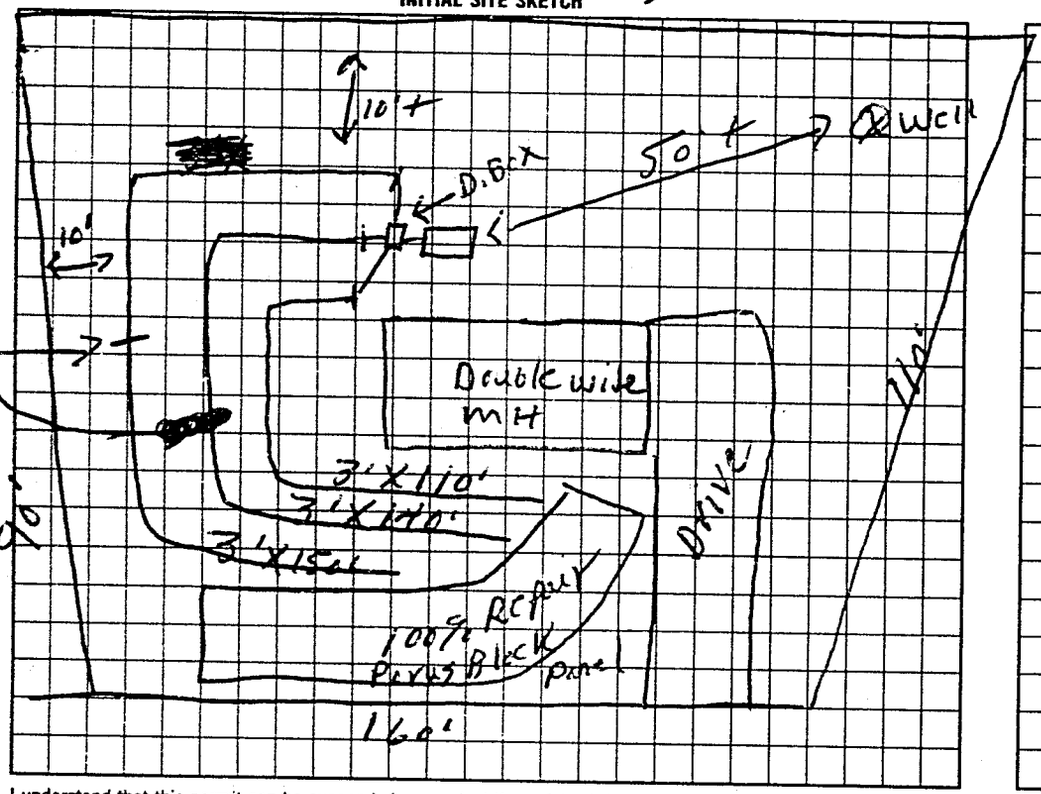


**AS BUILT SKETCH**

SAME AS INITIAL SKETCH

I understand that this permit can be suspended or revoked if any false information is supplied toward securing the permit/any unauthorized changes are made to the site/any unauthorized changes are made in the installation of the system. Improvement Permit is valid for 60 months from date of issuance.

Signed: [signature]

Improvement Permit by: P.C. Moore date 10-3-94

Existing System Inspection by: date

Installed by: A-1 Backhoe

Certificate of Completion by: Michael J. Dennis date 10-10-94

Operation Permit by: date

HEALTH DEPT COPY: WHITE INSPECTION COPY (FINAL): GREEN OWNER COPY (FINAL): YELLOW INSPECTION COPY (INITIAL): PINK OWNER COPY (INITIAL): GOLD