IREDELL COUNTY HEALTH DEPARTMENT

Statesville Phone TR 3-7271 Mooresville Phone NO 3-1271

PERMIT TO INSTALL SEPTIC TANK

Permit NO. 76 Permit Date March 9 1970

Owner J. Leroy Lam Poplin Assoc. Address Cmty. Hall Rd. Statesville N.C.

Installed By McLee Address Statesville N.C.


Location of Property on Rd #2342

Tank		Capacity		Length of Lines		Fixtures	
Block	( )	1000	( )	225'	(✓)	No. of Baths	( )
Precast	(✓)	1250	(✓)	250'	( )	Dishwasher	( )
		1500	( )	Other		Garbage Grdr.	( )
		Other				Other	

NOTIFY HEALTH DEPARTMENT AT LEAST EIGHT HOURS BEFORE TANK IS TO BE INSPECTED.

Final Inspection March 12 1970 Approved (✓) Disapproved ( )

Remarks

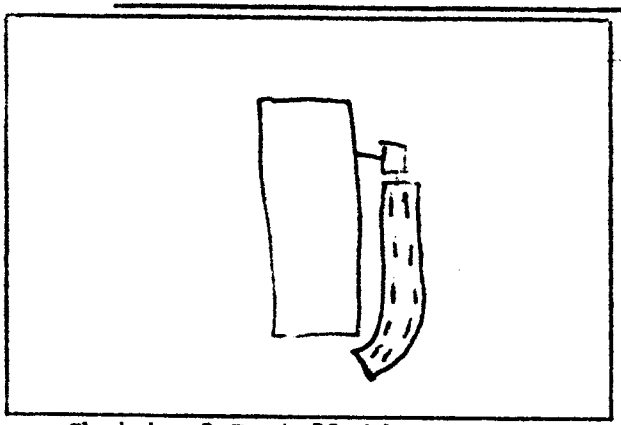

Sketch of Installation

Leslie C. Dickson E.S.

Sanitarian