IREDELL COUNTY HEALTH DEPARTMENT

STATESVILLE 704-878-5305 — MOORESVILLE 704-664-5281

IMPROVEMENT PERMIT / AUTHORIZATION TO CONSTRUCT / OPERATION PERMIT / EXISTING SYSTEM INSPECTION

D CI

PERMIT# 104050 Z0 PIN# 4751 61 89392 Diane 528-7123 DATE 1-16-2002

OWNER OR CONTRACTOR Shirley Collins PHONE: Business 281-8075 -Shirley Home (704) 660-6559

ADDRESS 251 South Broad St. Mooresville, NC

LOCATION Oswalt Amity Rd across from Arthurs Rd.

SUBDIVISION Providence BLOCK / SECTION ____ LOT 2 LOT AREA 1.17 Acres SITE CLASS PS DESIGN FLOW 360gpd T.A.R. .25-.3

Septic Tank: 1000 Gallons; STB 1012 Date 10-13-01

Pump Tank: ____ Gallons; PT ____ Date ____

Pump Make: ____ Model ____ Serial No. ____

Nitrification Field: No Fields 1 Square Feet ____ Linear Feet 440'

No Lines 4@110' Trench Width 36" Max Trench Bottom Depth 3

X New System ☐ Repair System Type: I (II) III. IV. V. VI

System Description: Gravity - Conventional

Repair System Description: Same

Maintenance Agreement Required: ☐ Yes ☐ No

Gravel Depth 12"

☐ House/Mod. Home ☐ Mobile Home ☐ Business ☐ Other

No. Bedrooms ____ No. Bathrooms ____ No. Employees ____


☐ Slab ☐ Crawl Space ☐ Basement w/plumbing ☐ Basement wo/plumbing

Water Supply: ☐ Individual ☐ Public ☐ Community

Comments/Conditions: Keep Septic Sytem at least 10' from PL & 100' to well.

Comments/Conditions: * Soil better towards back of lot & deeper. Install lines at 36"

INITIAL SITE SKETCH Scale 1:100'

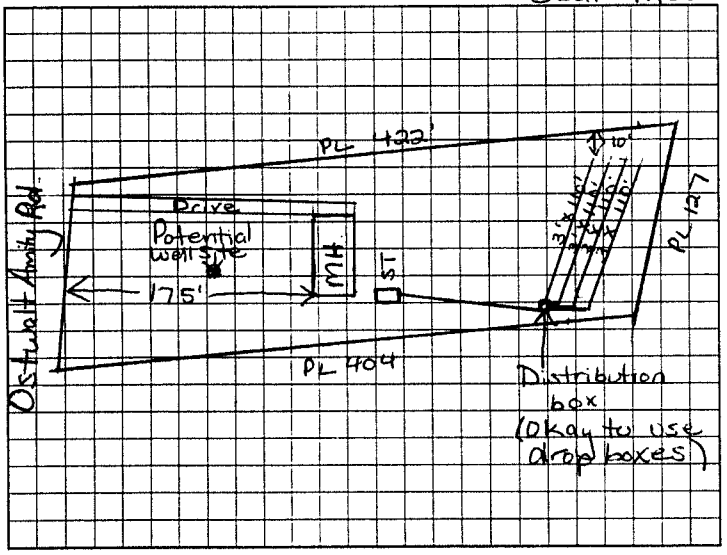

AS BUILT SKETCH

POLYLOK FILTER & MARK INSTALLED AS SHOWN

1 = 100'
2 = 185'
3 = 115'
4 = 120'
520'

SOILS APPEAR WORSE THAN GIVEN. FUTURE REPAIR MAY REQUIRE FRENCH DRAIN DUE TO MOTTLES

Permit can be suspended or revoked if any false information is supplied toward securing the permit/any unauthorized changes are made to the site/any unauthorized changes are made in the installation of the system. Improvement Permit with plat valid without expiration. Improvement Permit with site plan valid for sixty months. Authorization to Construct is valid for a period equal to that of Improvement Permit - not to exceed sixty months

Signed: Dennis Dalley date 1-16-02 installed by: A-1 BACKHOE

Improvement Permit by: Mariah H. Dotson R.S. date 1/16/2002 Operation Permit by: [signature] R.S. date 2-12-02

Authorization to Construct by: Mariah H. Dotson R.S. date 1/16/2002 Existing System Inspection by: ____ date ____

HEALTH DEPT COPY WHITE / OWNER COPY (FINAL) YELLOW / OWNER COPY (INITIAL) PINK