IREDELL COUNTY HEALTH DEPARTMENT

Statesville Office (704) 878-5305 Mooresville Office (704) 660-3625 PERMIT # 176311

IMPROVEMENT PERMIT / AUTHORIZATION TO CONSTRUCT / OPERATION PERMIT / EXISTING SYSTEM

PIN # 4751615610

APPLICANT: Ralph Justus APPLICANT ADDRESS: 655 Ostwalt Amity Rd.

SITE ADDRESS: 655 Ostwalt Amity Rd. Troutman PHONE: 704-883-4183 ALT. PHONE: 704-380-5936

SITE DIRECTIONS: Hwy 21 S TL Ostwalt Amity Rd. ~ 3 miles on Left

SUBDIVISION: N/A SECTION: N/A LOT # N/A LOT AREA: .803 acres DESIGN FLOW: 240 gpd L.T.A.R.: Existing

Septic Tank	Existing	(gal)	STB		Date						
Pump Tank		(gal)	PT		Date						
Pump Make			Model		Serial #						
# Nitrification Fields	6x	# Lines	6x	Linear Ft:	6x						
Trench Width	6x	Max. Trench Bottom Depth	6x	Gravel Depth	6x						

☐ New System ☐ Repair ☐ Expansion System Type: I (II) III IV V VI

System Description: Existing

Repair System Description:

Maintenance Agreement Required: ☐ YES ☑ NO

☑ GRAVITY ☐ PRESSURE

☑ Residence No. Bedrooms 2

☐ Business No. Persons

☐ Other No. Employees

☐ Slab ☑ Crawl Space

☐ Basement w/plumbing ☐ Basement w/o plumbing

Water Supply

☑ Private

☐ Public


☐ Community

Comments / Conditions:

- Maintain at least 25' between well & SWMH foundation; Maintain a minimum of 5' between SWMH foundation and all components of septic tank system.

INITIAL SITE SKETCH

AS-BUILT SKETCH

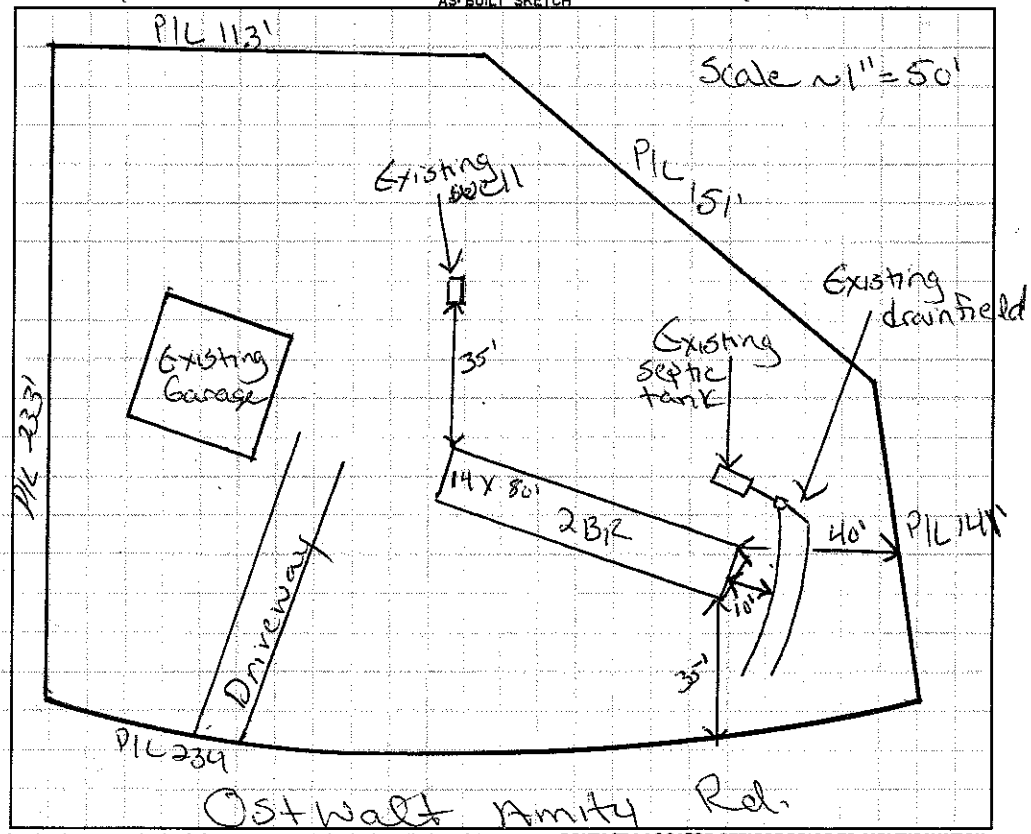

Permit can be suspended or revoked if any false information is supplied toward securing the permit / any unauthorized changes are made to the site / any unauthorized changes are made in the installation of the system. **CONTACT A LOCATOR SERVICE PRIOR TO ANY EXCAVATION**

☐ **IMPROVEMENT PERMIT** *with plat valid without expiration.* ☐ **IMPROVEMENT PERMIT** *with site plan valid for 60 mos.* ☐ **AUTHORIZATION TO CONSTRUCT** *valid for period equal to IMPROVEMENT PERMIT--not to exceed 60 mo.*

Owner / Applicant Signature: Ralph Justus Date: 1/22/13 Installed by:

IMPROVEMENT PERMIT by: Date: OPERATION PERMIT by: Date:

AUTHORIZATION TO CONSTRUCT by: Date: Existing System Inspected by: Justin Henderson Date: 12-13-12

Health Dept. Copy - WHITE Applicant (Final Approval) - YELLOW Applicant (Conditional Approval) - PINK