4:00

IREDELL COUNTY HEALTH DEPARTMENT

STATESVILLE 704-878-5305 MOORESVILLE 704-664-5281

IMPROVEMENT PERMIT / AUTHORIZATION TO CONSTRUCT / OPERATION PERMIT / EXISTING SYSTEM INSPECTION

PERMIT# 94537 PIN# 4751 70 0414 DATE 2/2/01

OWNER OR CONTRACTOR Teresa Newton PHONE: Business 663-5532 Home

ADDRESS Shepherd Rd. Troutman, NC. 28166

LOCATION Overcash Estates off Overcash Rd.

SUBDIVISION Overcash Est. BLOCK / SECTION LOT 8 LOT AREA ~1.04 SITE CLASS. PS DESIGN FLOW 360 L.T.A.R. .3

Septic Tank: 1000 Gallons; STB 1012 Date 1/1/00

Pump Tank: Gallons; PT 338 Date

Pump Make: Model Serial No.

Nitrification Field: No Fields 1 Square Feet 1200 Linear Feet 400

No Lines 4@100' Trench Width 3' Max Trench Bottom Depth 3' Gravel Depth 12"

☒ New System ☐ Repair System Type: I, (II), III, IV, V, VI

System Description: Gravel Conventional

Repair System Description: Same

Maintenance Agreement Required: ☐ Yes ☒ No

☐ House/Mod. Home ☒ Mobile Home ☐ Business ☐ Other


No. Bedrooms 3 No. Bathrooms 2 No. Employees

☐ Slab ☒ Crawl Space ☐ Basement w/plumbing ☐ Basement wo/plumbing

Water Supply: ☒ Individual ☐ Public ☐ Community

Comments:/Conditions:

INITIAL SITE SKETCH (1" = 50')

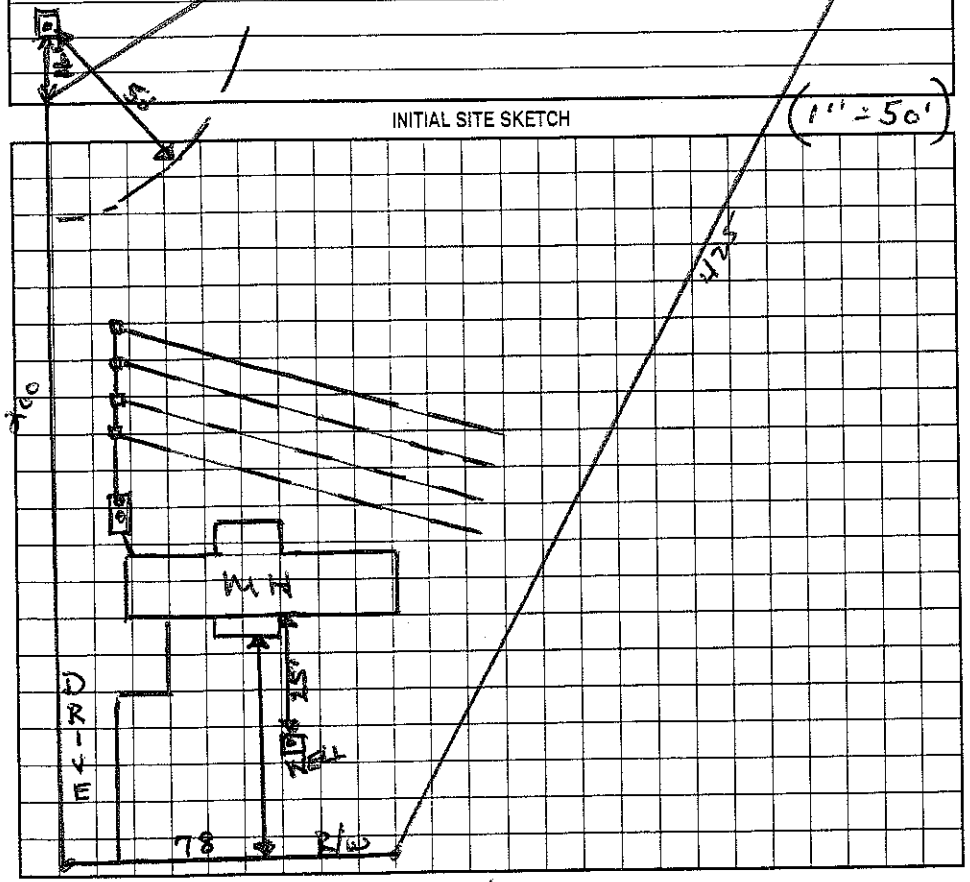

Comments:/Conditions:

AS BUILT SKETCH

Installed in 5 - 80 Ft Lines

Permit can be suspended or revoked if any false information is supplied toward securing the permit/any unauthorized changes are made to the site/any unauthorized changes are made in the installation of the system. Improvement Permit with plat valid without expiration. Improvement Permit with site plan valid for sixty months. Authorization to Construct is valid for a period equal to that of Improvement Permit -- not to exceed sixty months.

Signed: * Teresa Newton date 3/2/01

Improvement Permit by: Wesley Sparks RS date 3/2/01

Authorization to Construct by: Wesley Sparks RS date 3/2/01

Installed by: A-1 Backhoe

Operation Permit by: RSI date 3/9/01

Existing System Inspection by: date

HEALTH DEPT. COPY: WHITE OWNER COPY (FINAL): YELLOW OWNER COPY (INITIAL): PINK