IREDELL COUNTY HEALTH DEPARTMENT

STATESVILLE 704-878-5305 MOORESVILLE 704-664-5281

IMPROVEMENT PERMIT / AUTHORIZATION TO CONSTRUCT / OPERATION PERMIT / EXISTING SYSTEM INSPECTION

PERMIT# 89223 PIN# ~~4751 70 1311 Prof~~ 4751-70-1039 DATE 6/2/00

OWNER OR CONTRACTOR Teresa Newton PHONE: Business 528-0810 Home

ADDRESS 523 Shepherd Rd. Troutman, NC. 28166

LOCATION Westfield Creek TL Overcash Rd. on (L) past Kendall Rd. 4th lot on (L)

SUBDIVISION Overcash Estates BLOCK / SECTION LOT 4 LOT AREA .68 SITE CLASS. PS DESIGN FLOW 480 L.T.A.R. .3

Septic Tank: 1000 Gallons; STB 1012 Date 2/18/00
Pump Tank: Gallons; PT Date
Pump Make: Model Serial No.
Nitrification Field: No Fields 1 Square Feet 1680 Linear Feet 560
No Lines 7@ 80'x3' Trench Width 36" Max Trench Bottom Depth 36" Gravel Depth 12"

[X] New System [ ] Repair System Type: I (II) III, IV, V, VI
System Description: New - Conventional
Repair System Description: None
Maintenance Agreement Required: [ ] Yes [X] No


[X] House/Mod. Home No. Bedrooms 4
[ ] Mobile Home No. Bathrooms 3
[ ] Business No. Employees
[ ] Other
[ ] Slab [X] Crawl Space [ ] Basement w/plumbing [ ] Basement wo/plumbing

Water Supply: [X] Individual [ ] Public [ ] Community


Comments:/Conditions:

Comments:/Conditions:

INITIAL SITE SKETCH (1"=50')

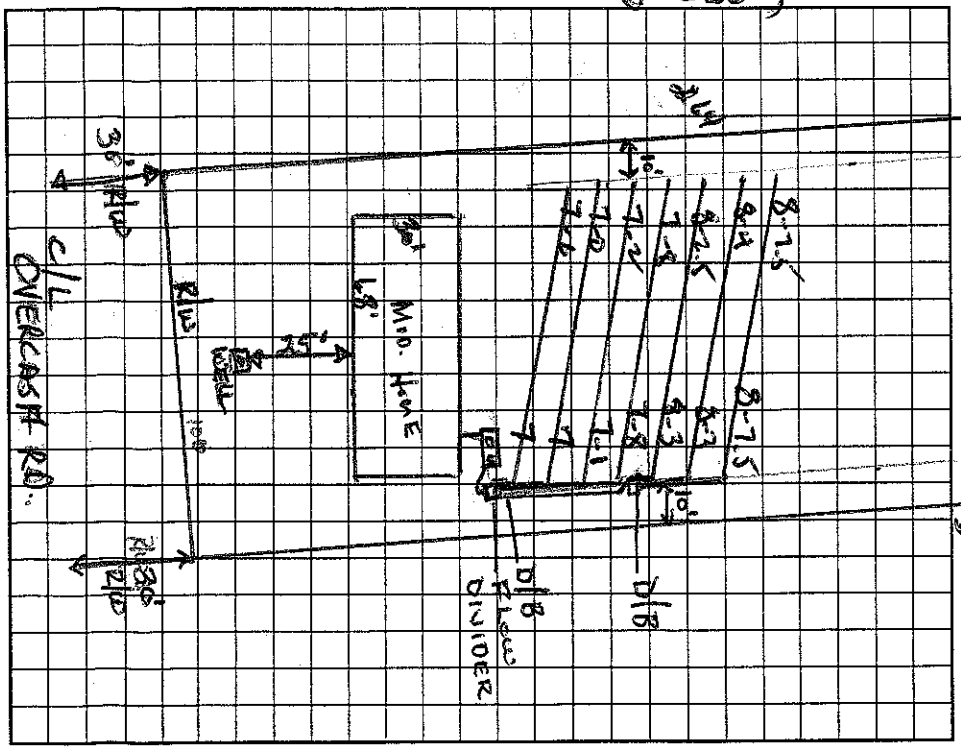

AS BUILT SKETCH

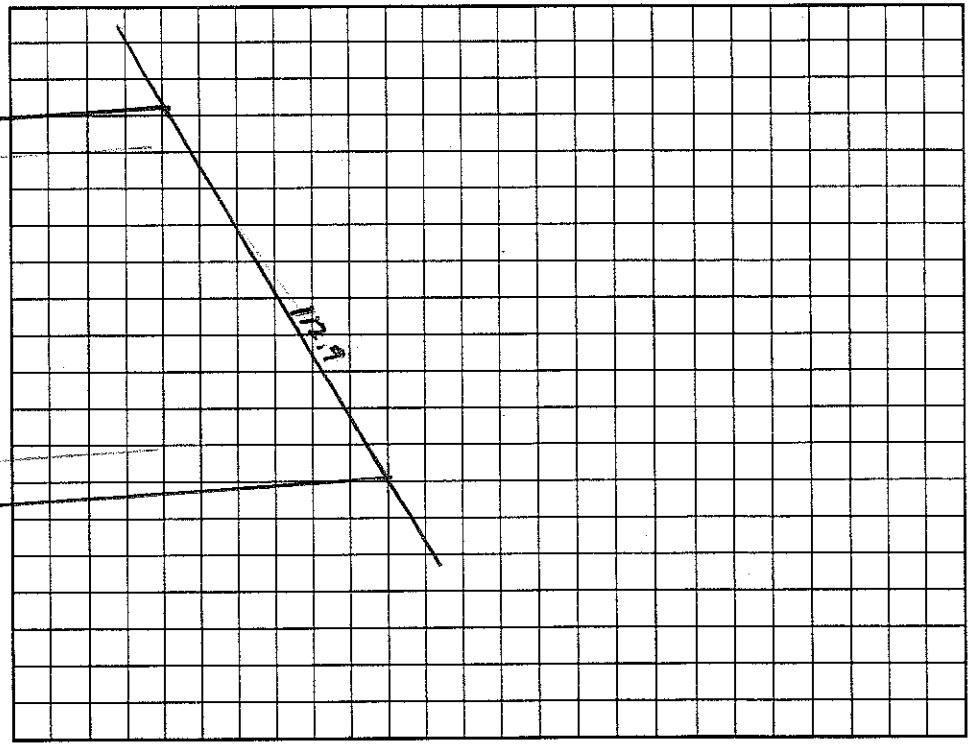

Permit can be suspended or revoked if any false information is supplied toward securing the permit/any unauthorized changes are made to the site/any unauthorized changes are made in the installation of the system. Improvement Permit with plat valid without expiration. Improvement Permit with site plan valid for sixty months. Authorization to Construct is valid for a period equal to that of Improvement Permit – not to exceed sixty months.

Signed: X Tracy J. Goodrum date 6-2-00 Installed by: A-1 Backhoe

Improvement Permit by: Wesley Sparks R.S. date 6/2/00 Operation Permit by: Wesley Sparks R.S. date 6/21/00

Authorization to Construct by: Wesley Sparks R.S. date 6/2/00 Existing System Inspection by: date

HEALTH DEPT. COPY: WHITE OWNER COPY (FINAL): YELLOW OWNER COPY (INITIAL): PINK