4:00

IREDELL COUNTY HEALTH DEPARTMENT

STATESVILLE 704-878-5305 MOORESVILLE 704-664-5281

IMPROVEMENT PERMIT / AUTHORIZATION TO CONSTRUCT / OPERATION PERMIT / EXISTING SYSTEM INSPECTION

PERMIT# 087655 PIN# 4751 70 1311 / 4751 03 034 DATE 2/28/00

OWNER OR CONTRACTOR Janice Harmon PHONE: Business Home 528-1345

ADDRESS 153 Windbrook Dr. Troutman, NC. 28166 / 141 Overcash Rd.

LOCATION Off Hwy TR Overcash, on (L) past 4th house

SUBDIVISION No BLOCK / SECTION LOT LOT AREA SITE CLASS. RS DESIGN FLOW 360 L.T.A.R. .3

Septic Tank: 1000 Gallons; STB 160 Date 3-8-00
Pump Tank: Gallons; PT Date
Pump Make: Model Serial No.
Nitrification Field: No Fields 1 Square Feet 1200 Linear Feet 400
No Lines 4 Trench Width 36" Max Trench Bottom Depth 36" Gravel Depth 12"

☒ New System ☐ Repair System Type: I, (II), III, IV, V, VI
System Description: Low-Conventional
Repair System Description: Same
Maintenance Agreement Required: ☐ Yes ☐ No

☐ House/Mod. Home No. Bedrooms 3
☒ Mobile Home No. Bathrooms 2
☐ Business No. Employees
☐ Other
☐ Slab ☐ Crawl Space ☐ Basement w/plumbing ☐ Basement wo/plumbing


Water Supply:
☒ Individual
☐ Public
☐ Community

Comments:/Conditions:

Comments:/Conditions: Filter installed
Checked tank & lines 1, 2 & 3 4/27/00 MD
MH ~~Stop~~ on site but not set up yet

1" = 50'

INITIAL SITE SKETCH

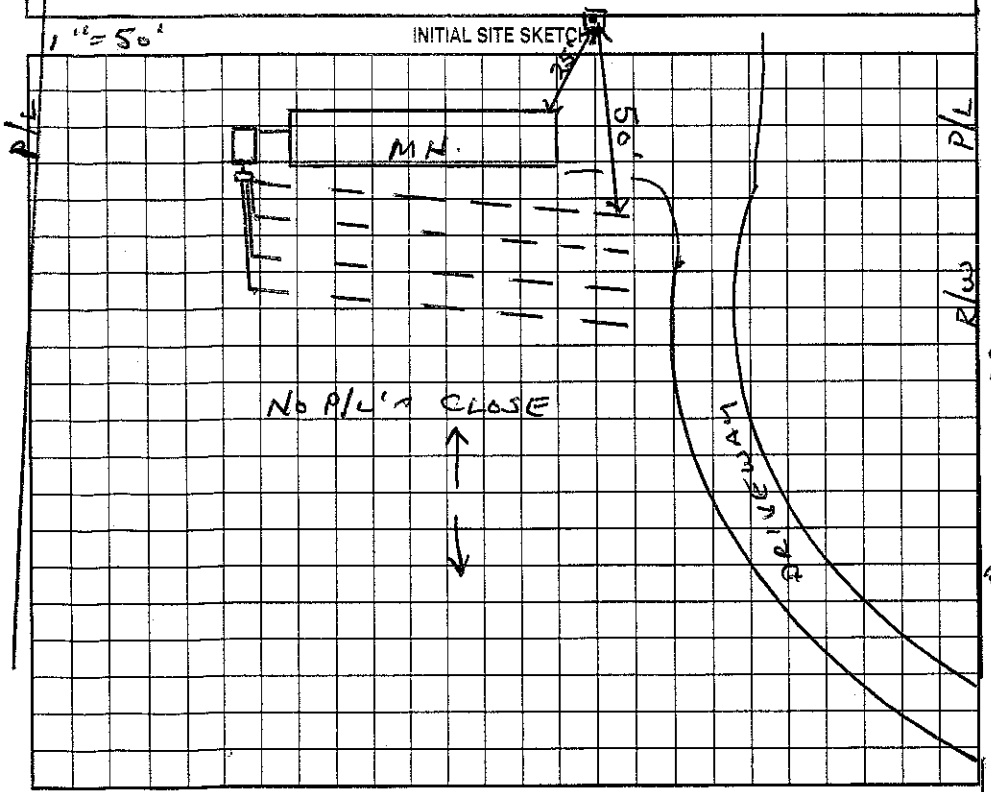

AS BUILT SKETCH

Permit can be suspended or revoked if any false information is supplied toward securing the permit/any unauthorized changes are made to the site/any unauthorized changes are made in the installation of the system. Improvement Permit with plat valid without expiration. Improvement Permit with site plan valid for sixty months. Authorization to Construct is valid for a period equal to that of Improvement Permit – not to exceed sixty months.

Signed: ✕ Janice Harmon date 2/28/00 Installed by: Barry Simon

Improvement Permit by: Wesley Sparks RS. date 2/28/00 Operation Permit by: Wesley Sparks RS. date 5/1/00

Authorization to Construct by: Wesley Sparks RS date 2/28/00 Existing System Inspection by: date

HEALTH DEPT. COPY: WHITE OWNER COPY (FINAL): YELLOW OWNER COPY (INITIAL): PINK