4751T04321

IREDELL COUNTY HEALTH DEPARTMENT

STATESVILLE 704-878-5305 MOORESVILLE 704-664-5281

IMPROVEMENT PERMIT / CERTIFICATE OF COMPLETION / OPERATION PERMIT / EXISTING SYSTEM INSPECTION

PROPERTY DESCRIPTION NO. 18173 DATE 4/26/94 TAX MAP NO. 4K 2A 6 Watershed: ☐ Yes ☒ No

OWNER OR CONTRACTOR Wm. K Miller III PHONE: Business _____ Home 528-5107

ADDRESS PO Box 1258 Troutman, NC.

LOCATION Windbrook Dr. Asbury (R) on Oconeeah Rd. (L) on Windbrook to 5th Lot on (L)

SUBDIVISION Windbrook BLOCK / SECTION _____ LOT 6 LOT AREA .75 AC SITE CLASS. P DESIGN FLOW 240 L.T.A.R. .25-.3

Septic Tank: 1000 Gallons; STB 994 Date 5/4/94

Pump Tank: _____ Gallons; PT _____ Date _____

Pump Make: _____ Model _____ Serial No. _____

Nitrification Field: No Fields 1 Square Feet 960 Linear Feet 320

No. Lines 4 Trench Width 3' Max Trench Bottom Depth 28-30" Gravel Depth 12"

☒ New System ☐ Repair System Type: I (II) III, IV, V, VI

System Description: CONV (SHALLOW) + DROP BOX

Repair System Description: _____

Maintenance Agreement Required: ☐ Yes ☐ No

☐ House/Mod. Home No. Bedrooms 2

☒ Mobile Home No. Bathrooms 2

☐ Business No. Employees _____

☐ Other _____


☐ Slab ☐ Crawl Space ☐ Basement w/plumbing ☐ Basement wo/plumbing

Water Supply: ☒ Individual ☐ Community ☐ Public

Conditions: Gully Smoothup before installing Trench depth 28-30" MAX.

Comments:

INITIAL SITE SKETCH

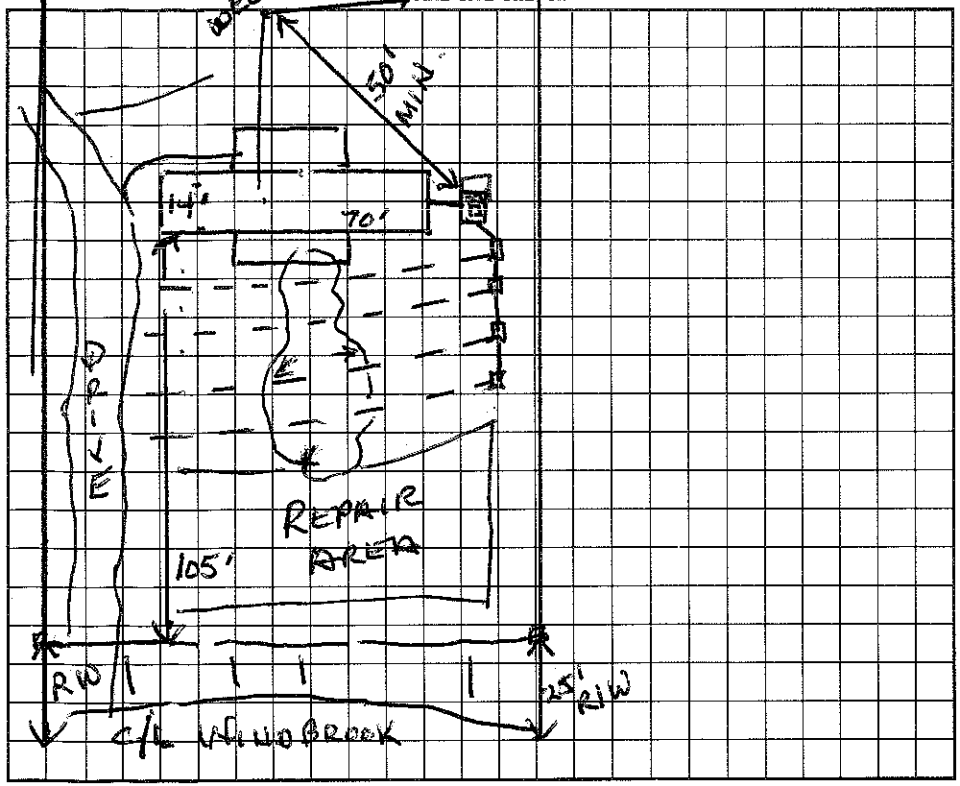

AS BUILT SKETCH

I understand that this permit can be suspended or revoked if any false information is supplied toward securing the permit/any unauthorized changes are made to the site/any unauthorized changes are made in the installation of the system. Improvement Permit is valid for 60 months from date of issuance.

Signed: Jacqueline Miller

Improvement Permit by: Wesley Sparks RS. date 4/26/94

Existing System Inspection by: _____ date _____

Installed by: Dellinger Septic Tank

Certificate of Completion by: Wesley Sparks RS. date 7/18/94

Operation Permit by: _____ date _____

HEALTH DEPT. COPY: WHITE INSPECTION COPY (FINAL): GREEN OWNER COPY (FINAL): YELLOW INSPECTION COPY (INITIAL): PINK OWNER COPY (INITIAL): GOLD