4751 71 0412

IREDELL COUNTY HEALTH DEPARTMENT

STATESVILLE 704-878-5305 MOORESVILLE 704-664-5281

IMPROVEMENT PERMIT / CERTIFICATE OF COMPLETION / OPERATION PERMIT / EXISTING SYSTEM INSPECTION

PROPERTY DESCRIPTION NO. 19062 DATE 6/17/94 TAX MAP NO. 4K-1-A (8-18) Watershed: ☐ Yes ☑ No

OWNER OR CONTRACTOR Wm + Dewana Sievert PHONE: Business _____ Home 872-0808

ADDRESS 161 Henderson Dr. Styl. NC. 28677

LOCATION Os Amity Rd; on (L) of intersection after (R) turn onto Owencash Rd.

SUBDIVISION Lowdermilk BLOCK / SECTION 1 LOT (161 - 112) LOT AREA 2 1. to AC SITE CLASS. P DESIGN FLOW 360 L.T.A.R. .25 - .3

Septic Tank: 1000 Gallons; STB 794 Date 5/11/94

Pump Tank: _____ Gallons; PT _____ Date _____

Pump Make: _____ Model _____ Serial No. _____

Nitrification Field: No Fields 1 Square Feet 1440 Linear Feet 480

No Lines 4 Trench Width 3' Max Trench Bottom Depth 32" Gravel Depth 12"

☑ New System ☐ Repair System Type: I (II) III, IV, V, VI

System Description: CONV - DIST. BOX - Sp. Level

Repair System Description: _____

Maintenance Agreement Required: ☐ Yes ☐ No

☐ House/Mod. Home No. Bedrooms 3

☑ Mobile Home D/W No. Bathrooms 2

☐ Business No. Employees ____

☐ Other _____

☐ Slab ☑ Crawl Space ☐ Basement w/plumbing ☐ Basement wo/plumbing

Water Supply: ☑ Individual ☐ Community ☐ Public


Comments:

Trench depth 32", Dist Box with Sped Levels - CONTOURS

Comments:

Installed as drawn.

INITIAL SITE SKETCH

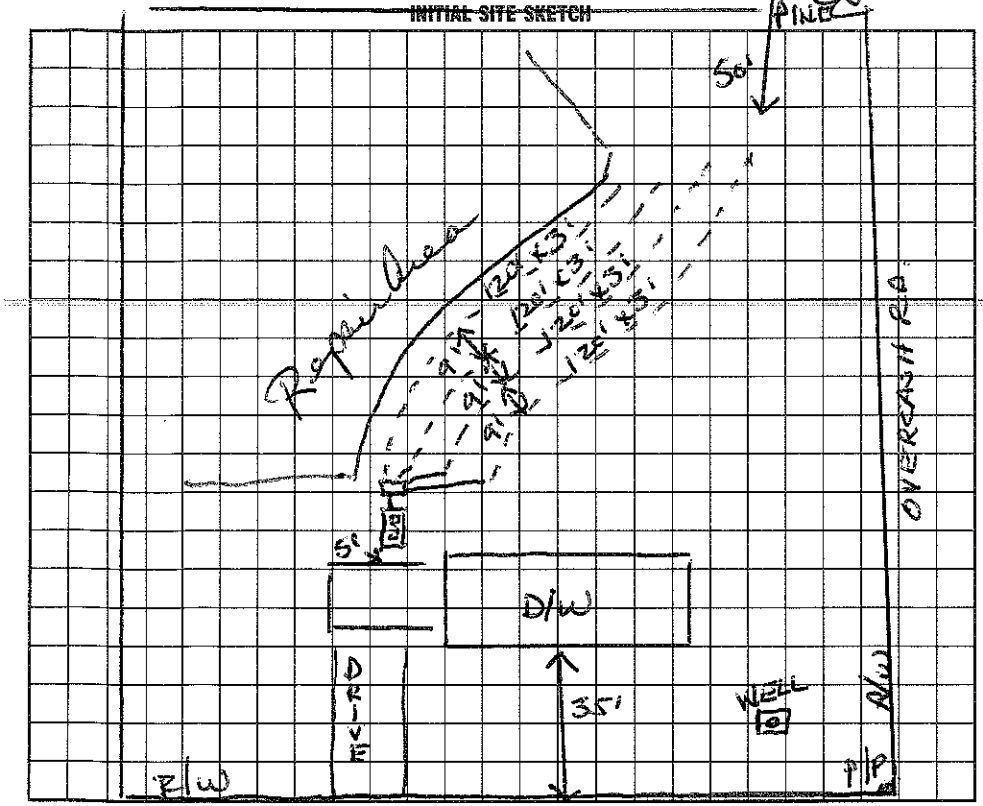

AS BUILT SKETCH

I understand that this permit can be suspended or revoked if any false information is supplied toward securing the permit/any unauthorized changes are made to the site/any unauthorized changes are made in the installation of the system. Improvement Permit is valid for 60 months from date of issuance. OSWALTAMITY

Signed: X Dewana Sievert

Improvement Permit by: Wesley Sparks RS. date 6/17/94

Existing System Inspection by: _____ date _____

Installed by: J.C. Forsyth

Certificate of Completion by: Wesley Sparks RS date 7/6/94

Operation Permit by: _____ date _____

HEALTH DEPT. COPY: WHITE INSPECTION COPY (FINAL): GREEN OWNER COPY (FINAL): YELLOW INSPECTION COPY (INITIAL): PINK OWNER COPY (INITIAL): GOLD