EDELL COUNTY HEALTH DEPARTMENT

STATESVILLE 704-878-5305 MOORESVILLE 704-664-5281

IMPROVEMENT PERMIT / CERTIFICATE OF COMPLETION / OPERATION PERMIT / EXISTING SYSTEM INSPECTION

PROPERTY DESCRIPTION NO. 16660 DATE 7/15/93 | 4751-71-1009 TAX MAP NO. 4K 1A 23

OWNER OR CONTRACTOR MILAS A GAMBLE PHONE: Business _____ Home 528-4596

ADDRESS BOX 507 RT 1 TROUTMAN, NC

LOCATION OVERCASH RD, OFF AMITY RD FRM 115N, TR ON OVERCASH TO 2ND RH ON ℄

SUBDIVISION LOUDERMILK SUBD. BLOCK / SECTION _____ LOT 17-120 LOT AREA 100'x200' SITE CLASS. P L.T.A.R. .3

Water Supply: ☑ Individual ☐ Community ☐ Public

Septic Tank: 1000 Gallons; STB 825 Date 8-1-93

Pump Tank: _____ Gallons; PT _____ Date _____

Nitrification Field: No Fields 1 Square Feet 1200 Linear Feet 400

No Lines 4 Trench Width 36" Trench Depth 28-30" Gravel Depth 12"

☑ New System ☐ Repair System Type: I (II) II, IV, V, VI

System Description: GRAVITY-CONV

Repair System Description: GRAVITY - CONV.

Maintenance Agreement Required: ☐ Yes ☑ No

☑ House/Mod. Home ☐ Mobile Home ☐ Business ☐ Other

No. Bedrooms 3 No. Bathrooms 2 No. Employees _____

Garbage Disposal: ☐ Yes ☑ No

Auto. Dishwasher: ☑ Yes ☐ No


Auto. Washing Machine: ☑ Yes ☐ No

Other _____


☐ Slab ☑ Crawl Space ☐ Basement w/plumbing ☐ Basement wo/plumbing

Comments 28-30" TRENCH DEPTH - CONTOURS TO BE FOLLOWED CLOSELY
SPEED LEVELERS REQUIRED WITH DIST. BOX
W
SOILS - CLAY - STICKY - PLASTIC - 3DK

INITIAL SITE SKETCH

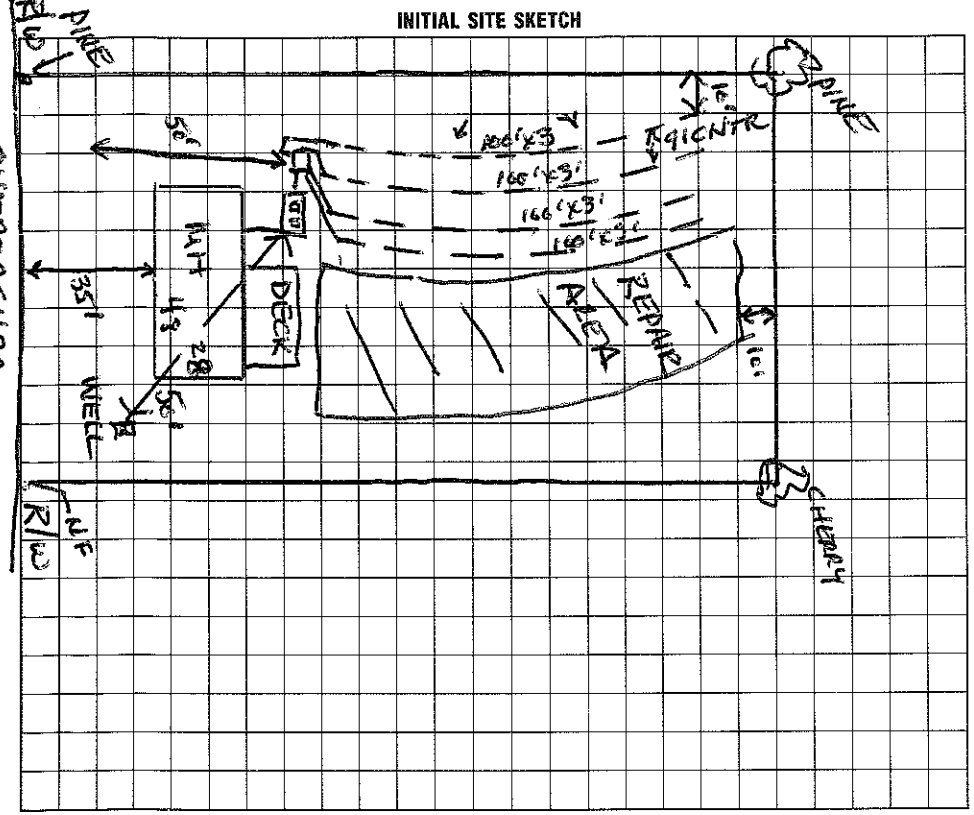

AS BUILT SKETCH

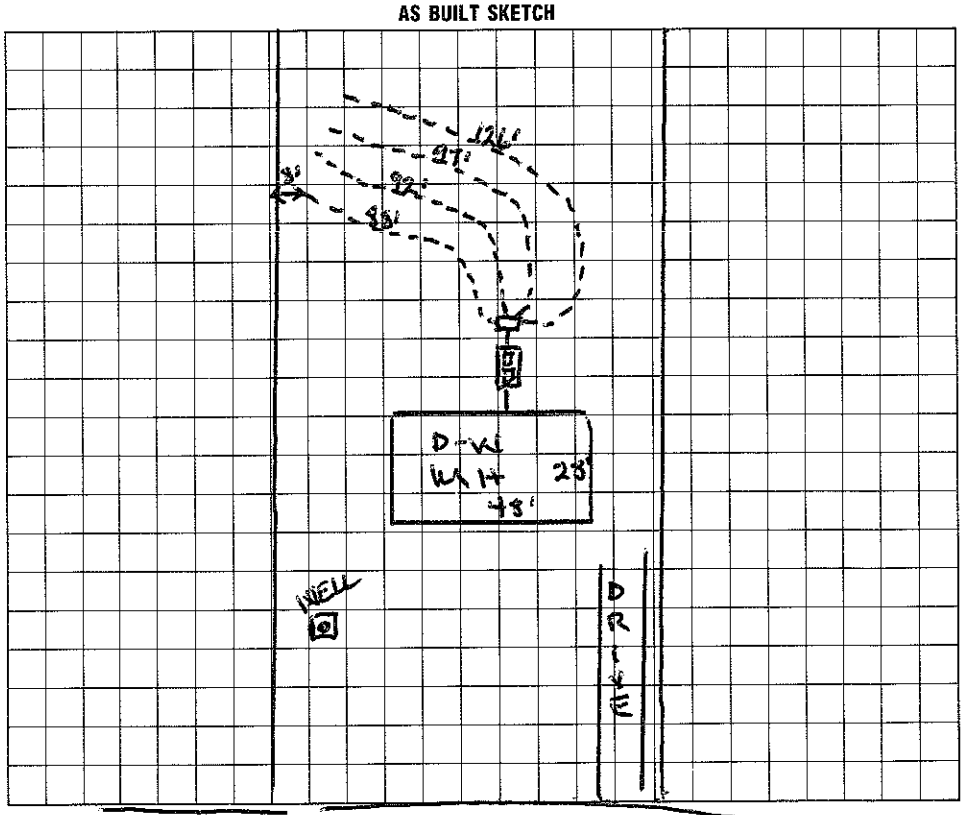

I understand that this permit can be suspended or revoked if any false information is supplied toward securing the permit/any unauthorized changes are made to the site/any unauthorized changes are made in the installation of the system. Improvement Permit is valid for 60 months from date of issuance.

Signed: Milas A. Gamble

Improvement Permit by: Wesley Sparks R.S. date 7/15/93

Existing System Inspection by: _____ date _____

Installed by: CWTHERSON

Certificate of Completion by: Wesley Sparks R.S. date 9/3/93

Operation Permit by: _____ date _____

HEALTH DEPT. COPY: WHITE INSPECTION COPY (FINAL): GREEN OWNER COPY (FINAL): YELLOW INSPECTION COPY (INITIAL): PINK OWNER COPY (INITIAL): GOLD