IREDELL COUNTY HEALTH DEPARTMENT

Authorization to Construct 4751711009

STATESVILLE 704-878-5305 MOORESVILLE 704-664-5281

IMPROVEMENT PERMIT / ~~CERTIFICATE OF COMPLETION~~ / OPERATION PERMIT / EXISTING SYSTEM INSPECTION

PROPERTY DESCRIPTION NO. 24111 DATE 7/15/96 TAX MAP NO. 46 B41 Watershed: ☐ Yes ☒ No

OWNER OR CONTRACTOR London Phifer PHONE: Business _____ Home 528-5885

ADDRESS 446 Weathers Creek Rd. Troutman NC.

LOCATION Os Amity Rd TR Overcash Rd. TR Weathers Creek 500' on (R) past Winfred Rd.

SUBDIVISION _____ BLOCK / SECTION _____ LOT _____ LOT AREA ~.50 AC SITE CLASS PS DESIGN FLOW 360 L.T.A.R. .3

Septic Tank: 1000 Gallons; STB 600 Date 5/8/96

Pump Tank: _____ Gallons; PT _____ Date _____

Pump Make: _____ Model _____ Serial No. _____

Nitrification Field: No Fields 1 Square Feet 1200 Linear Feet 400

No Lines 4 Trench Width 36" Max Trench Bottom Depth 30-32" Gravel Depth 16"

☒ New System ☐ Repair System Type: I, II, III, IV, V, VI

System Description: DIST BOX - CONV.

Repair System Description: PANEL

Maintenance Agreement Required: ☐ Yes ☒ No

☐ House/Mod. Home No. Bedrooms 3

☒ Mobile Home No. Bathrooms 2

☐ Business No. Employees _____

☐ Other _____


☐ Slab ☒ Crawl Space ☐ Basement w/plumbing ☐ Basement wo/plumbing

Water Supply: ☒ Individual ☐ Community ☐ Public


Comments: Lines on slope contour in direction shown.

Comments:

INITIAL SITE SKETCH

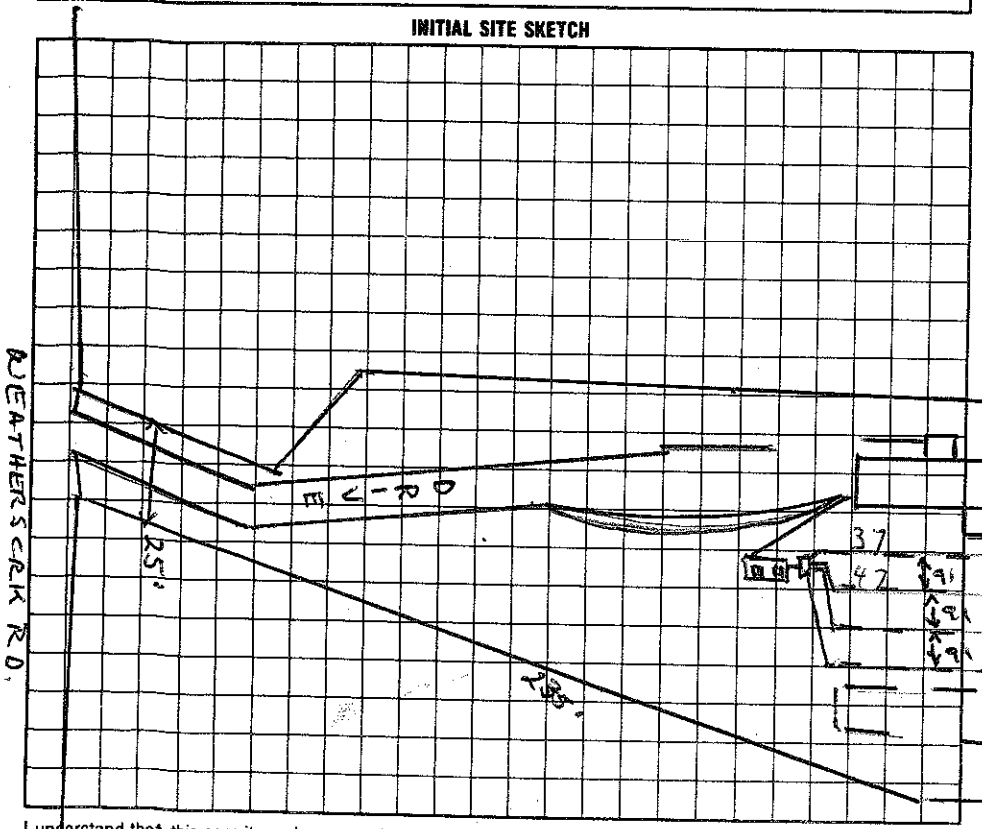

AS BUILT SKETCH

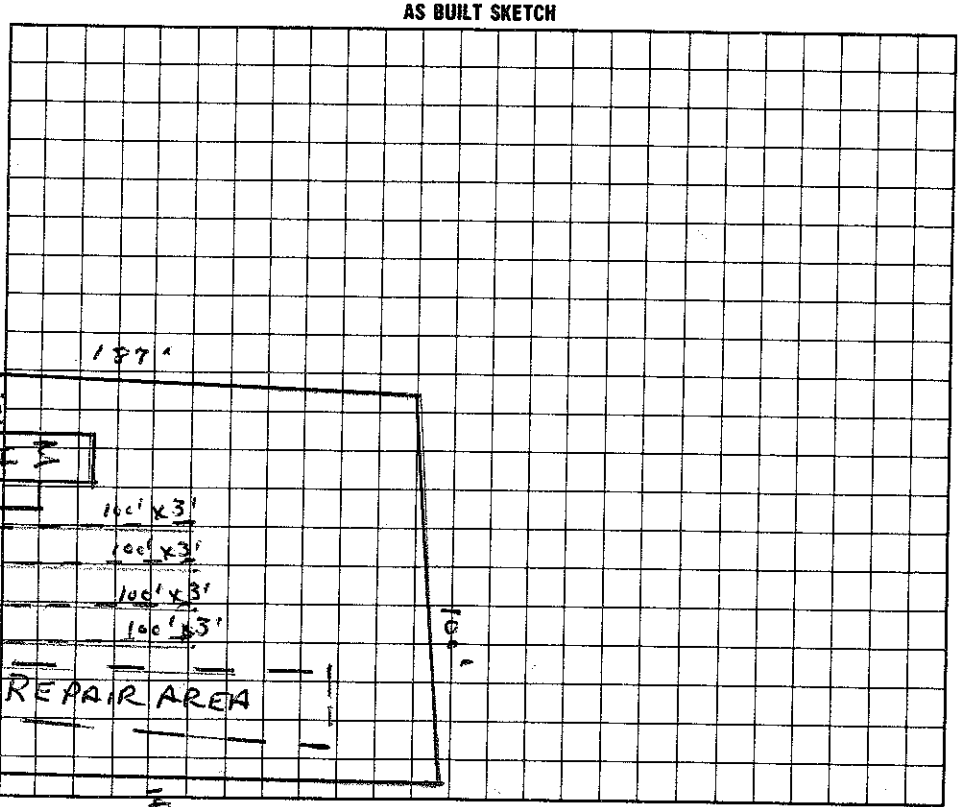

I understand that this permit can be suspended or revoked if any false information is supplied toward securing the permit/any unauthorized changes are made to the site/any unauthorized changes are made in the installation of the system.

Signed: * Joanne C. Phifer

Improvement Permit by: Wesley Sparks RS. date 7/15/96

Authorization to Construct / Existing System Inspection by: Wesley Sparks RS. date 7/15/96

Installed by: Sammy Davis

Certificate of Completion by: _____ date _____

Operation Permit by: L. Ray Stevens date 5/9/96

HEALTH DEPT. COPY: WHITE INSPECTION COPY (FINAL): GREEN OWNER COPY (FINAL): YELLOW INSPECTION COPY (INITIAL): PINK OWNER COPY (INITIAL): GOLD