IREDELL COUNTY HEALTH DEPARTMENT

STATESVILLE 704-878-5305 MOORESVILLE 704-664-5281

IMPROVEMENT PERMIT / AUTHORIZATION TO CONSTRUCT / OPERATION PERMIT / EXISTING SYSTEM INSPECTION

Addition

PERMIT# 076498 PIN# 4751716861 DATE 9/17/98

OWNER OR CONTRACTOR Tim Senter PHONE: Home Business 528-9975 Home Freedom Homes - Jennifer 528-4449

ADDRESS 110 Anne bell Rd Troutman NC 28166

LOCATION US 21 TR Oswalt Amity TR 1st dirt Rd past Overcash - Annebelle Rd

SUBDIVISION _____ BLOCK / SECTION _____ LOT J LOT AREA Pt of Acreage SITE CLASS. _____ DESIGN FLOW 360gpd L.T.A.R. .125 - 3

Septic Tank: 1000 Gallons; STB _____ Date _____

Pump Tank: _____ Gallons; PT _____ Date _____

Pump Make: _____ Model _____ Serial No. _____

Nitrification Field: No Fields 1 Square Feet 840 Linear Feet 280

No Lines 4 Trench Width 36" Max Trench Bottom Depth 18"-23" Gravel Depth 12"

☐ New System ☐ Repair System Type: I, II, III, IV, V, VI

System Description: Gravity Conventional

Repair System Description: _____

Maintenance Agreement Required: ☐ Yes ☒ No

☐ House/Mod. Home No. Bedrooms 3

☒ Mobile Home No. Bathrooms _____

☐ Business No. Employees _____

☐ Other _____

☐ Slab ☒ Crawl Space ☐ Basement w/plumbing ☐ Basement wo/plumbing

Water Supply: ☒ Individual ☐ Public ☐ Community


Next Door

Comments:/Conditions: Upgrade System From 2 Bedrooms to 3 Bedrooms. Add 1 line 3'X70' to Existing System, stay 5' From Buildings. Keep line STRAIGHT, add downhill off Existing System

Comments:/Conditions: Existing System appeared to be Functioning okay at time of Inspection on 9/17/98 (Original permit attached - Installed 3/27/85

Not to Scale

INITIAL SITE SKETCH

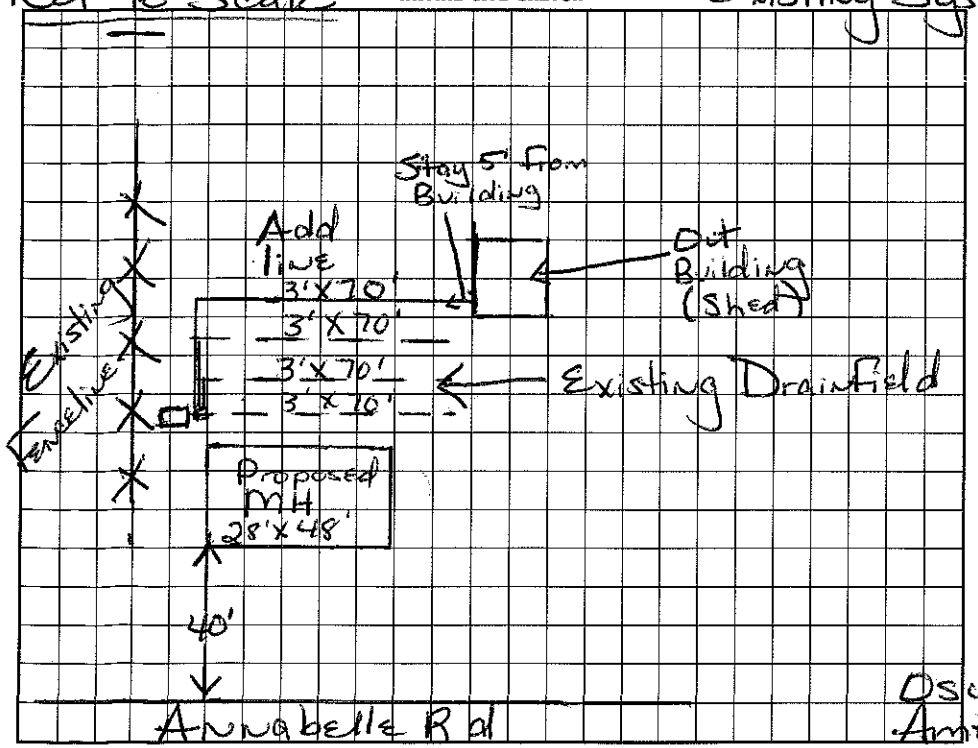

AS BUILT SKETCH

I understand that this permit can be suspended or revoked if any false information is supplied toward securing the permit/any unauthorized changes are made to the site/any unauthorized changes are made in the installation of the system. Improvement Permit with plat valid without expiration. Improvement Permit with site plan valid for sixty months. Authorization to Construct is valid for a period equal to that of Improvement Permit – not to exceed sixty months.

Signed: Jennifer C. King date 9/17/98 Installed by: OWNER

Improvement Permit by: Marietta Dobson RS date 9/17/98 Operation Permit by: C. Bryan date 9/24/98

Authorization to Construct by: Marietta Dobson RS date 9/17/98 Existing System Inspection by: _____ date _____

HEALTH DEPT. COPY: WHITE INSPECTION COPY (FINAL): GREEN OWNER COPY (FINAL): YELLOW INSPECTION COPY (INITIAL): PINK OWNER COPY (INITIAL): GOLD