4751719782

# IREDELL COUNTY HEALTH DEPARTMENT

AUTHORIZATION TO CONSTRUCT 3:00 Before

STATESVILLE 704-878-5305 MOORESVILLE 704-664-5281

## IMPROVEMENT PERMIT / ~~CERTIFICATE OF COMPLETION~~ / OPERATION PERMIT / EXISTING SYSTEM INSPECTION

PROPERTY DESCRIPTION NO. 068406 DATE 8/5/97

OWNER OR CONTRACTOR STEVE OVERCASH (MIKE YOUNG) TAX MAP NO. 4674465100

ADDRESS 40 106 LEDGEWOOD LN MOORESVILLE NC 28115 PHONE: Business 880 Home 664-2774

LOCATION 136 S - TR FOUR TRAX DR, ON LEFT Watershed: ☑ Yes ☑ No

SUBDIVISION — BLOCK / SECTION — LOT — LOT AREA 113.93 SITE CLASS. PS DESIGN FLOW 360 L.T.A.R. .3

Septic Tank: 1000 Gallons; STB 794 Date 12/8/98

Pump Tank: ____ Gallons; PT ____ Date ____

Pump Make: ____ Model ____ Serial No. ____

Nitrification Field: No Fields 1 Square Feet 1200 Linear Feet 400

No Lines 3 @ 133' Trench Width 36" Max Trench Bottom Depth 36" Gravel Depth 12"

☑ New System ☐ Repair System Type: I, II, III, IV, V, VI

System Description: GRAVITY CONVENTIONAL

Repair System Description: GRAVITY CHAMBERED

Maintenance Agreement Required: ☐ Yes ☑ No

☑ House/Mod. Home ☐ Mobile Home ☐ Business ☐ Other

No. Bedrooms 3 No. Bathrooms 2½ No. Employees ____


☐ Slab ☑ Crawl Space ☐ Basement w/plumbing ☐ Basement wo/plumbing

Water Supply: ☑ Individual ☐ Community ☐ Public

Comments:


Comments:

### INITIAL SITE SKETCH

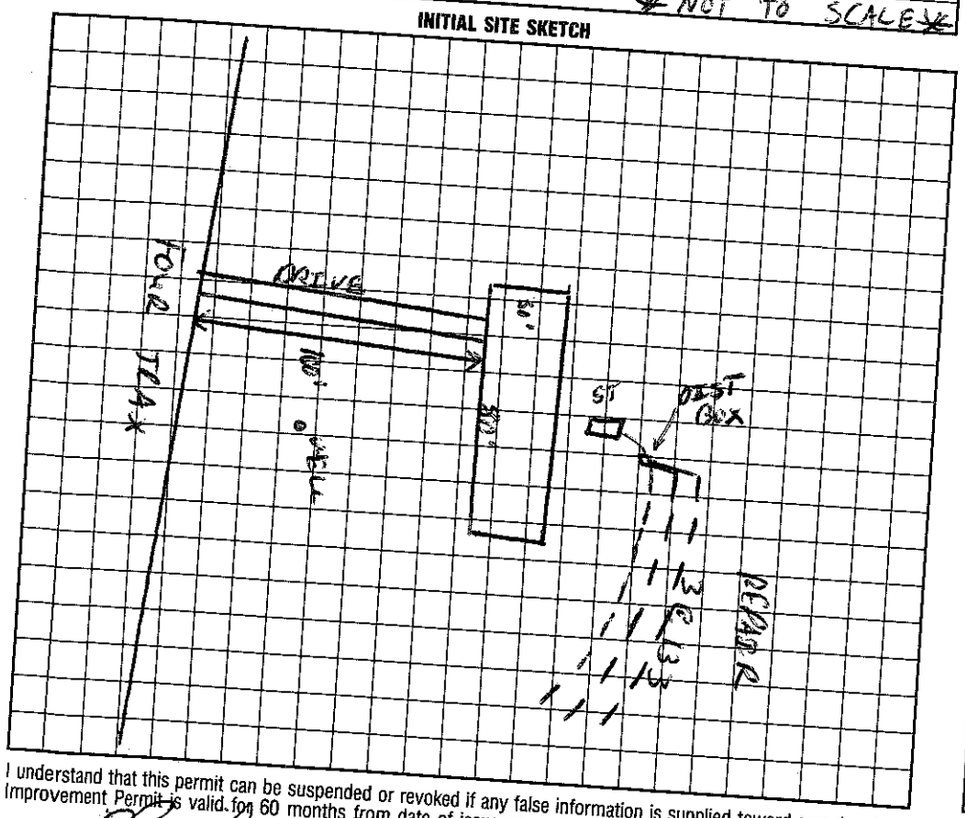


✱ NOT TO SCALE ✱

### AS BUILT SKETCH

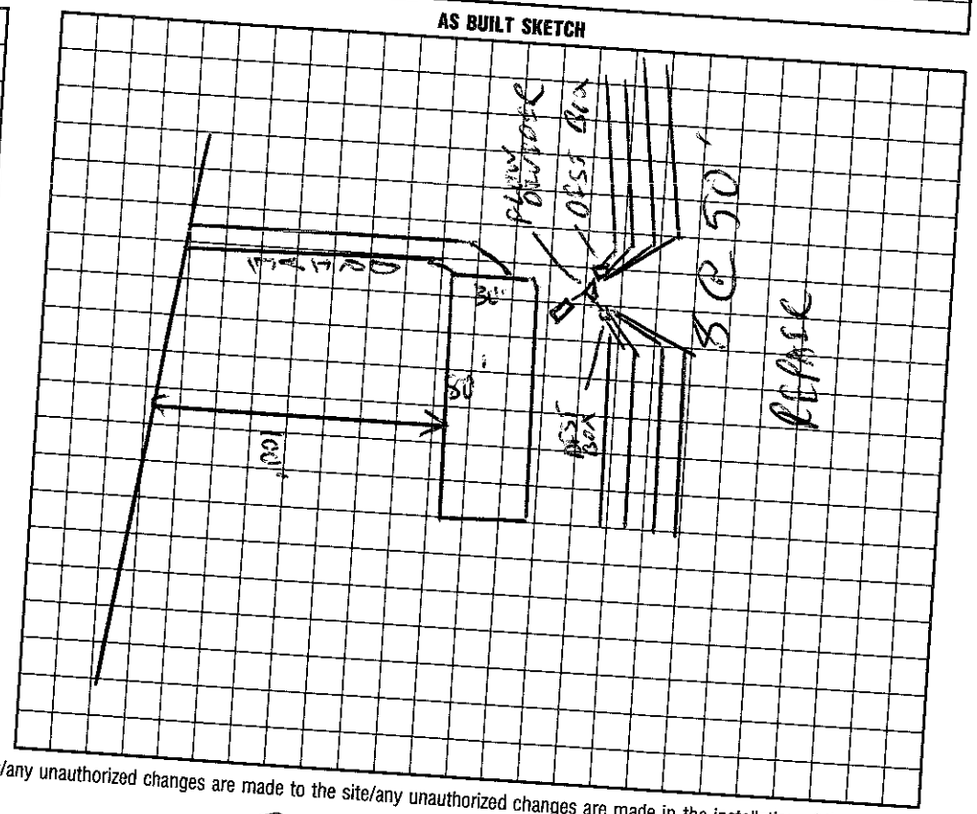


I understand that this permit can be suspended or revoked if any false information is supplied toward securing the permit/any unauthorized changes are made to the site/any unauthorized changes are made in the installation of the system. Improvement Permit is valid for 60 months from date of issuance.

Signed: [signature]

Improvement Permit by: C. [signature] date 8/5/97

~~Existing System Inspection by:~~ ~~AUTHORIZATION TO CONSTRUCT~~ C. [signature] date 8/5/97

HEALTH DEPT. COPY: WHITE INSPECTION COPY (FINAL): GREEN OWNER COPY (FINAL): YELLOW

Installed by: FJ ELVIN

Certificate of Completion by: ____ date ____

Operation Permit by: C. [signature] date 4/22/98

INSPECTION COPY (INITIAL): PINK OWNER COPY (INITIAL): GOLD