IREDELL COUNTY HEALTH DEPARTMENT

STATESVILLE 704-878-5305 MOORESVILLE 704-664-5281

IMPROVEMENT PERMIT / AUTHORIZATION TO CONSTRUCT / OPERATION PERMIT / EXISTING SYSTEM INSPECTION

PERMIT# 119430 PIN# ~~4957-62-8066~~ 4751-62-8121 / 4751722146 DATE 4-20-04

OWNER OR CONTRACTOR SHIRLEY J. COLLINS PHONE: Business (704) 281-8075 Home

ADDRESS 251 S. BROAD STREET MOORESVILLE NC 28115

LOCATION I-77S EXIT 45 (L) AMITY HILL RD. (R) OSWALT AMITY RD ~2 MI. ON (R) PAST 719 BEFORE SHARP CURVE

SUBDIVISION BLOCK / SECTION LOT LOT AREA ~20 AC SITE CLASS. PS DESIGN FLOW 360 L.T.A.R. .25 GPD/FT²

Septic Tank: 1000 Gallons; STB 350 Date 12-15-04
Pump Tank: 1000 Gallons; PT 318 Date 11-10-04
Pump Make: ZOELLER Model N-153 Serial No.
Nitrification Field: No Fields 1 Square Feet 1440 Linear Feet 360
No Lines 6 Trench Width 36" Max Trench Bottom Depth 18" Gravel Depth N/A

☑ New System ☐ Repair System Type: I, II, (III), IV, V, VI
System Description: PUMP 25% REDUCTION
Repair System Description: SAME-SHALLOW PLACEMENT
Maintenance Agreement Required: ☐ Yes ☑ No

☑ House/Mod. Home No. Bedrooms 3
☐ Mobile Home No. Bathrooms 2
☐ Business No. Employees
☐ Other
☐ Slab ☑ Crawl Space ☐ Basement w/plumbing ☐ Basement wo/plumbing


Water Supply: ☑ Individual ☐ Public ☐ Community

Comments:/Conditions: (1) INSTALL LINES AT 18" ON CONTOUR (2) WELL MUST BE AT LEAST 100' FROM ANY PART OF SEPTIC SYSTEM (3) MAINTAIN ALL OTHER SETBACKS (4) INSTALL ACCORDING TO SKETCH


Comments:/Conditions: (5) PACK AND FILL ANY GULLIES NEAR SYSTEM. (6) SUPPLY LINE UNDER DRIVEWAY SHALL BE ENCASED IN DUCTILE IRON.

INITIAL SITE SKETCH

Scale 1"=100'

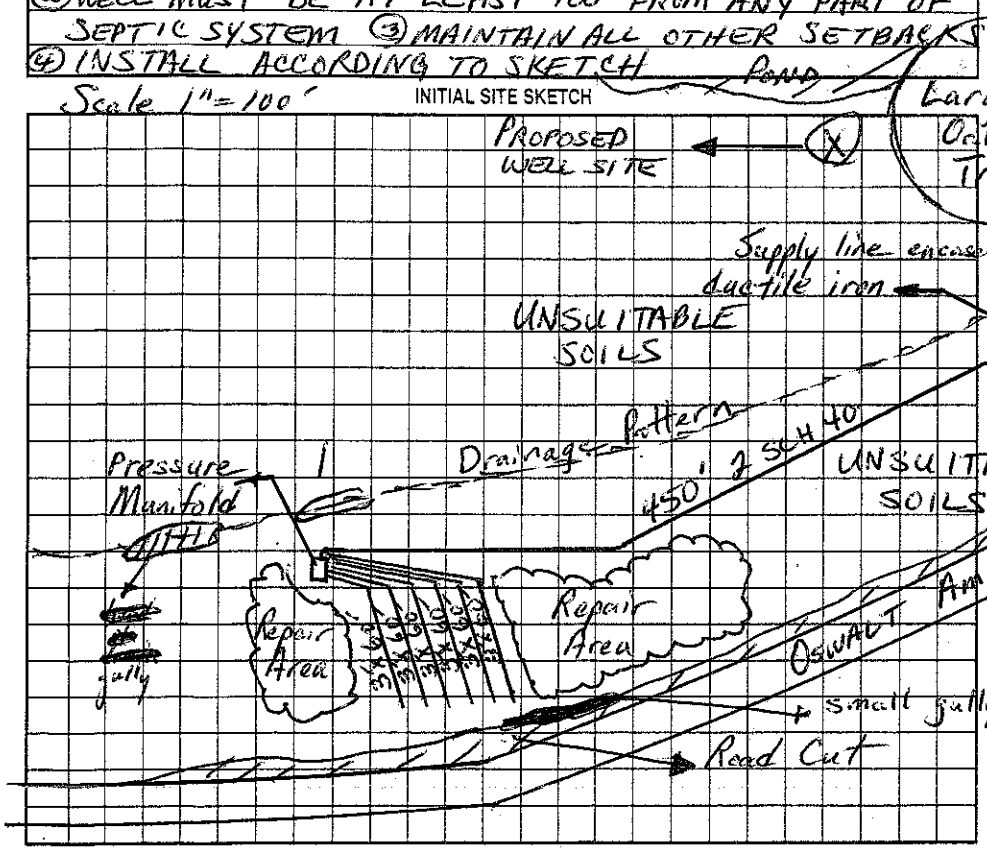

AS BUILT SKETCH

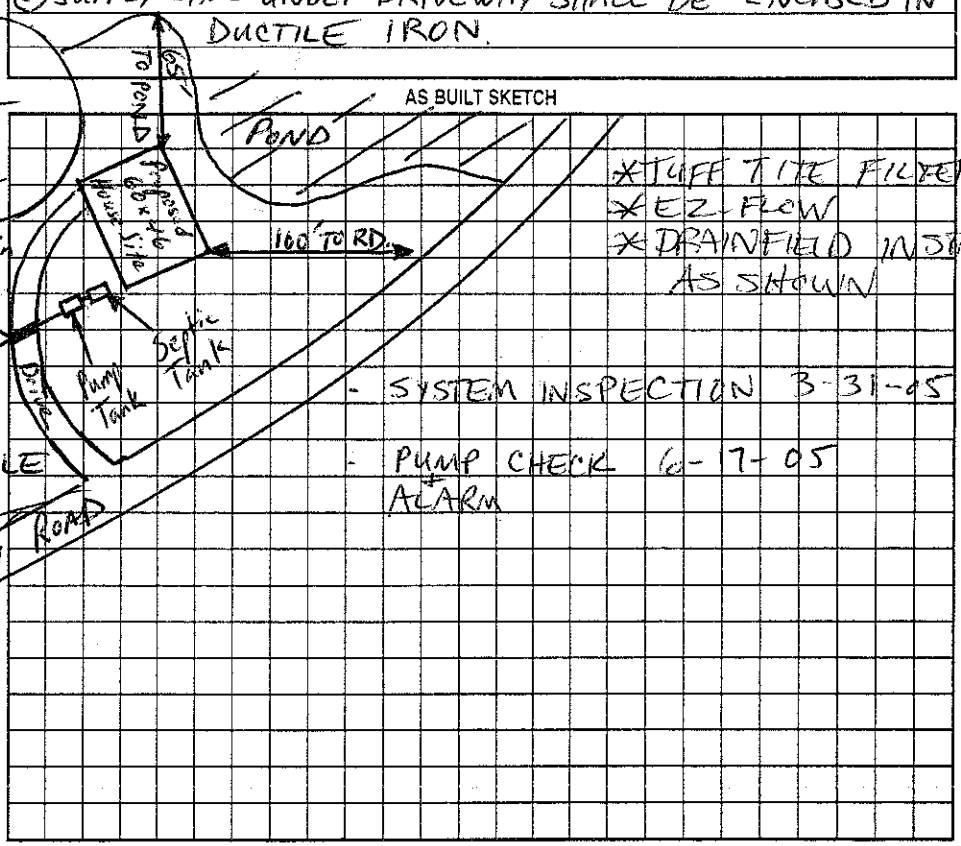

* TUFF TITE FILTER
* EZ-FLOW
* DRAINFIELD INSTALLED AS SHOWN

- SYSTEM INSPECTION 3-31-05
- PUMP CHECK 6-17-05 ALARM

Permit can be suspended or revoked if any false information is supplied toward securing the permit/any unauthorized changes are made to the site/any unauthorized changes are made in the installation of the system. Improvement Permit with plat valid without expiration. Improvement Permit with site plan valid for sixty months. Authorization to Construct is valid for a period equal to that of Improvement Permit – not to exceed sixty months.

Signed: Robert Jackson date Installed by: PIEDMONT SEPTIC

Improvement Permit by: Christopher M. Sherrill, RS date 4-20-04 Operation Permit by: Christopher M. Sherrill, RS, LSS date 6-17-05

Authorization to Construct by: Christopher M. Sherrill, RS date 4-20-04 Existing System Inspection by: date

HEALTH DEPT. COPY: WHITE OWNER COPY (FINAL): YELLOW OWNER COPY (INITIAL): PINK