IREDELL COUNTY HEALTH DEPARTMENT

STATESVILLE 704-878-5305 MOORESVILLE 704-664-5281

IMPROVEMENT PERMIT / AUTHORIZATION TO CONSTRUCT / OPERATION PERMIT / EXISTING SYSTEM INSPECTION

PERMIT# Repair PIN# DATE 3-19-99

OWNER OR CONTRACTOR Phillip Daggenhart PHONE: Business 881-0417 Home

ADDRESS 3525 Amity Hill Rd Statesville

LOCATION I-77 S to Amity Hill Rd Exit 45 1st lot on L past Shiloh Church

SUBDIVISION 0 BLOCK / SECTION LOT LOT AREA SITE CLASS P/S DESIGN FLOW 360 L.T.A.R. Existing

Septic Tank: Existing Gallons: STB Date

Pump Tank: 0 Gallons: PT Date

Pump Make: Model Serial No.

Nitrification Field: No Fields 1 Square Feet Linear Feet 330ft

No Lines 4 Trench Width 36in Max Trench Bottom Depth 36in

☐ New System ☒ Repair System Type: I II III IV V VI

System Description:

Repair System Description: Grade Conventional

Maintenance Agreement Required: ☐ Yes ☐ No

Gravel Depth 12in ☐ Slab ☒ Crawl Space ☐ Basement w/plumbing ☐ Basement wo/plumbing

☒ House/Mod. Home No. Bedrooms 3

☐ Mobile Home No. Bathrooms 1

☐ Business No. Employees


☐ Other

Water Supply: ☒ Individual ☐ Public ☐ Community


Comments/Conditions: Install 1 line @ 120ft (line will be deep)
Install 3 lines on contour
Keep 10ft from property line

Comments/Conditions: Note Tank sits 90° as shown

INITIAL SITE SKETCH

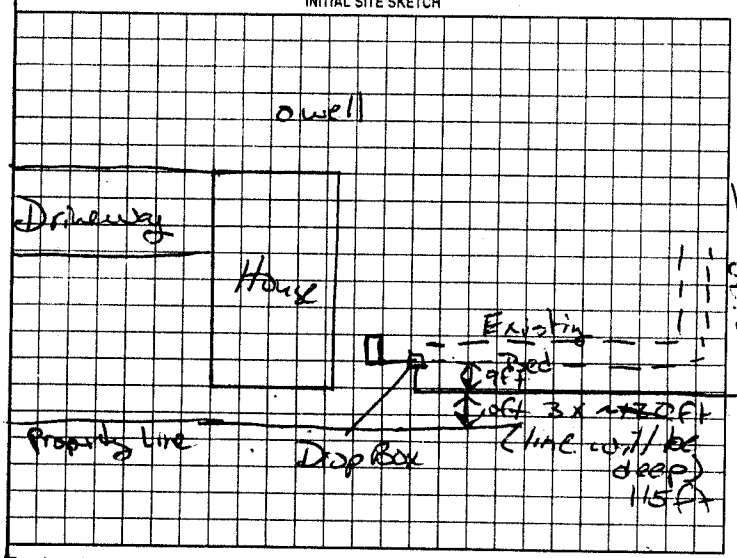

AS BUILT SKETCH

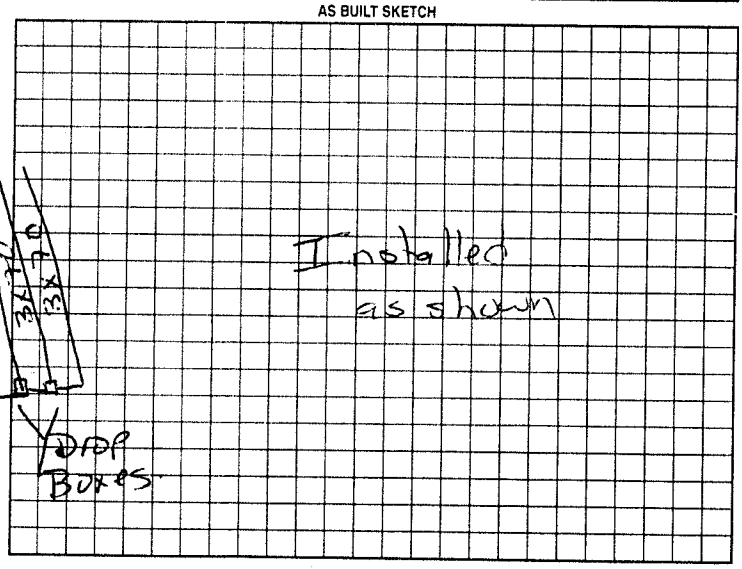

Permit can be suspended or revoked if any false information is supplied toward securing the permit/any unauthorized changes are made to the site/any unauthorized changes are made in the installation of the system. Improvement Permit with plat valid without expiration. Improvement Permit with site plan valid for sixty months. Authorization to Construct is valid for a period equal to that of Improvement Permit – not to exceed sixty months.

Signed: Phillip Daggenhart date 3-19-99 Installed by: Steve Jordan

Improvement Permit by: Mary C. Cuff RS date 3-19-99 Operation Permit by: Mary C. Cuff RS date 3-29-99

Authorization to Construct by: Mary C. Cuff RS date 3-19-99 Existing System Inspection by: date

HEALTH DEPT. COPY WHITE OWNER COPY (FINAL) YELLOW OWNER COPY (INITIAL) PINK