IREDELL COUNTY HEALTH DEPARTMENT

STATESVILLE 704-878-5305 MOORESVILLE 704-664-5281

IMPROVEMENT PERMIT / AUTHORIZATION TO CONSTRUCT / OPERATION PERMIT / EXISTING SYSTEM INSPECTION

PERMIT# No PIN# 4751821347 DATE 11/7/02

OWNER OR CONTRACTOR Chris Shaw PHONE: Business 902-0086 Home

ADDRESS 746 Oswalt Amity Rd. Troutman, NC 28166

LOCATION 115-21 N TR Oswalt Amity Rd. on (R) just past Annabell Rd.

SUBDIVISION No BLOCK / SECTION LOT No LOT AREA EXISTING SITE CLASS. PS DESIGN FLOW 360 L.T.A.R. .3

Septic Tank: EXISTING Gallons; STB Date

Pump Tank: Gallons; PT Date

Pump Make: Model Serial No.

Nitrification Field: No Fields Square Feet 900 Linear Feet 300

No Lines 4@75' Trench Width 3' Max Trench Bottom Depth 3' Gravel Depth No

☐ New System ☒ Repair System Type: I, II, (III), IV, V, VI

System Description: GRAVITY - 25% REDUCED

Repair System Description: GRAVITY - 25% REDUCED

Maintenance Agreement Required: ☐ Yes ☒ No

☒ House/Mod. Home No. Bedrooms 3

☐ Mobile Home No. Bathrooms 2

☐ Business No. Employees

☐ Other

☐ Slab ☐ Crawl Space ☐ Basement w/plumbing ☒ Basement wo/plumbing


Water Supply: ☒ Individual ☐ Public ☐ Community

Comments:/Conditions: REPAIR PERMIT

Comments:/Conditions: EZLAY INSTALLED - DROP BOXES

WELL IS BURIED, OR UNDER HOUSE

INITIAL SITE SKETCH

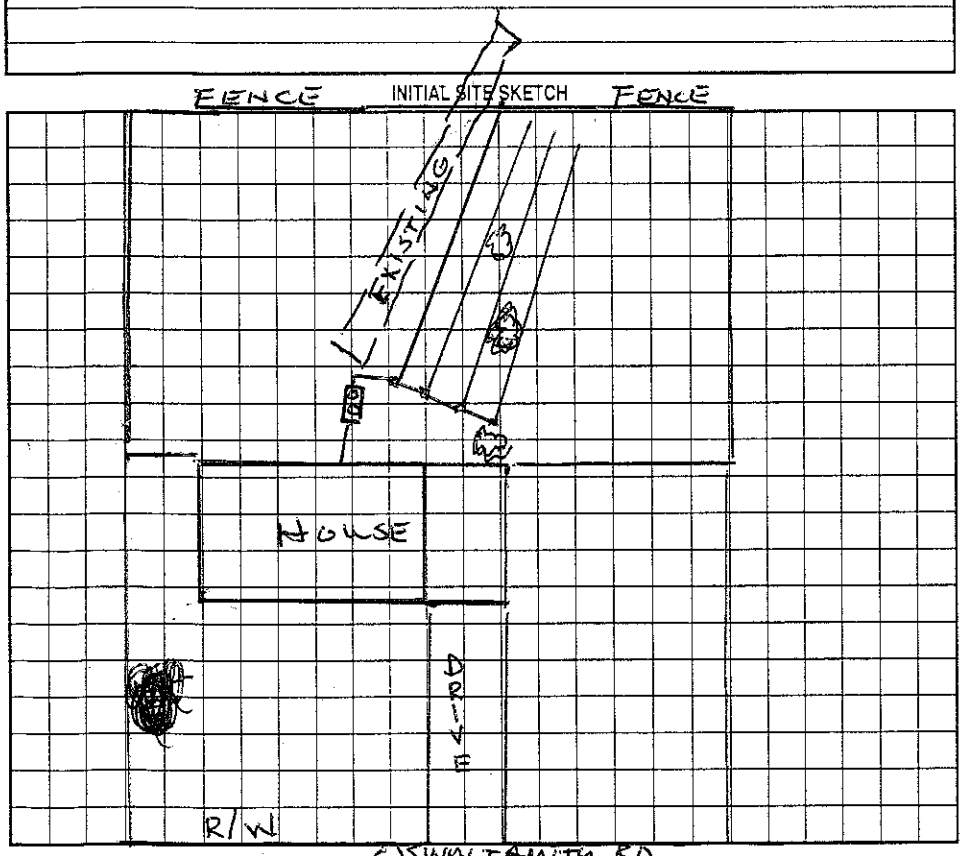

AS BUILT SKETCH

Permit can be suspended or revoked if any false information is supplied toward securing the permit/any unauthorized changes are made to the site/any unauthorized changes are made in the installation of the system. Improvement Permit with plat valid without expiration. Improvement Permit with site plan valid for sixty months. Authorization to Construct is valid for a period equal to that of Improvement Permit – not to exceed sixty months.

Signed: Chris Shaw date 11-13-02 Installed by: James Hudlow

Improvement Permit by: Wesley Sparks RS. date 11/6/02 Operation Permit by: Wesley Sparks RS. date 11/15/02

Authorization to Construct by: Wesley Sparks RS. date 11/6/02 Existing System Inspection by: date

HEALTH DEPT. COPY: WHITE OWNER COPY (FINAL): YELLOW OWNER COPY (INITIAL): PINK