IREDELL COUNTY HEALTH DEPARTMENT

STATESVILLE 704-878-5305 MOORESVILLE 704-664-5281

IMPROVEMENT PERMIT / AUTHORIZATION TO CONSTRUCT / OPERATION PERMIT / EXISTING SYSTEM INSPECTION

PERMIT# 115022 PIN# 4751-86-5628 DATE 8/22/03

OWNER OR CONTRACTOR ERIC THOMPSON PHONE: Business 902-7668 Home

ADDRESS 3606 AMITY HILL RD - STATESVILLE NC 28677

LOCATION OSWALT AMITY - TL AMITY HILL - ON LEFT 3RD HOUSE - # 3606

SUBDIVISION — BLOCK / SECTION — LOT — LOT AREA 1.98 AC SITE CLASS. PS DESIGN FLOW 360GPD L.T.A.R. EXISTING

Septic Tank: 1000 Gallons; STB Date

Pump Tank: EXISTING Gallons: PT Date

Pump Make: Model Serial No.

Nitrification Field: No Fields Square Feet Linear Feet

No Lines Trench Width Max Trench Bottom Depth Gravel Depth

☑ New System ☐ Repair System Type: I (II) III, IV, V, VI

System Description: GRAVITY CONVENTIONAL

Repair System Description: SAME

Maintenance Agreement Required: ☐ Yes ☑ No

☑ House/Mod. Home ☐ Mobile Home ☐ Business ☐ Other

No. Bedrooms 3 No. Bathrooms 3 No. Employees


☐ Slab ☑ Crawl Space ☐ Basement w/plumbing ☐ Basement wo/plumbing

Water Supply: ☑ Individual ☐ Public ☐ Community

Comments:/Conditions: SYSTEM FUNCTIONING PROPERLY AT TIME OF INSPECTION.

Comments:/Conditions:

INITIAL SITE SKETCH 1"=46'

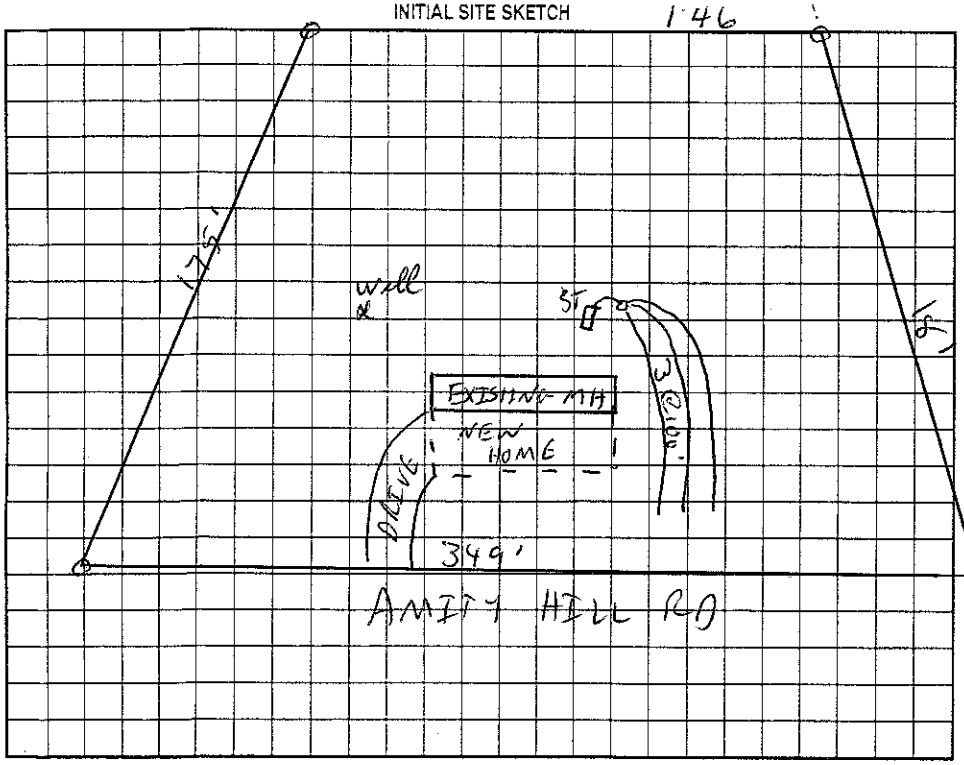

AS BUILT SKETCH

Permit can be suspended or revoked if any false information is supplied toward securing the permit/any unauthorized changes are made to the site/any unauthorized changes are made in the installation of the system. Improvement Permit with plat valid without expiration. Improvement Permit with site plan valid for sixty months. Authorization to Construct is valid for a period equal to that of Improvement Permit – not to exceed sixty months.

Signed: [signature] date 8-26-03 Installed by:

Improvement Permit by: date Operation Permit by: date

Authorization to Construct by: date Existing System Inspection by: [signature] RS date 8/22/03

HEALTH DEPT. COPY: WHITE OWNER COPY (FINAL): YELLOW OWNER COPY (INITIAL): PINK