IREDELL COUNTY HEALTH DEPARTMENT

STATESVILLE 704-878-5305 MOORESVILLE ~~704-664-5281~~ @

IMPROVEMENT PERMIT / AUTHORIZATION TO CONSTRUCT / OPERATION PERMIT **EXISTING SYSTEM INSPECTION**

PERMIT # 162972 PIN # 4751-86-8688 DATE 31 August 10

OWNER or APPLICANT Ada Martin PHONE: Business Home: (704) 528-2295

OWNER or APPLICANT ADDRESS 116 Starlight Rd. Statesville

LOCATION / DIRECTIONS Amity Hill Rd. Turn onto Starlight, on Rt.

SUBDIVISION BLOCK / SECTION LOT # LOT AREA 0.52 ac. DESIGN FLOW 240 gpd L.T.A.R.

Septic Tank Existing Gallons: STB Date

Pump Tank Gallons: P T Date

Pump Make Model Serial #

Nitrification Field No Fields 1 No Lines 1 Linear Feet ~ 75'

Trench Width ~ 6' Max. Trench Bottom Depth Gravel Depth

☐ New System ☐ Repair ☐ Expansion System Type I (II) III IV V VI

System Description: Conventional - bed

Repair System Description:

Maintenance Agreement Required ☐ YES ☒ NO

☑ GRAVITY ☐ PRESSURE

☑ Residence No. Bedrooms 2

☐ Business No. Persons

☐ Other No. Employees

☐ Slab ☑ Crawl Space

☐ Basement w/plumbing ☐ Basement w/o plumbing


Water Supply: ☑ Private ☐ Public ☐ Community

Comments / Conditions

Comments / Conditions Keep mobile home 5' from all portions of septic system.

INITIAL SITE SKETCH

AS BUILT SKETCH

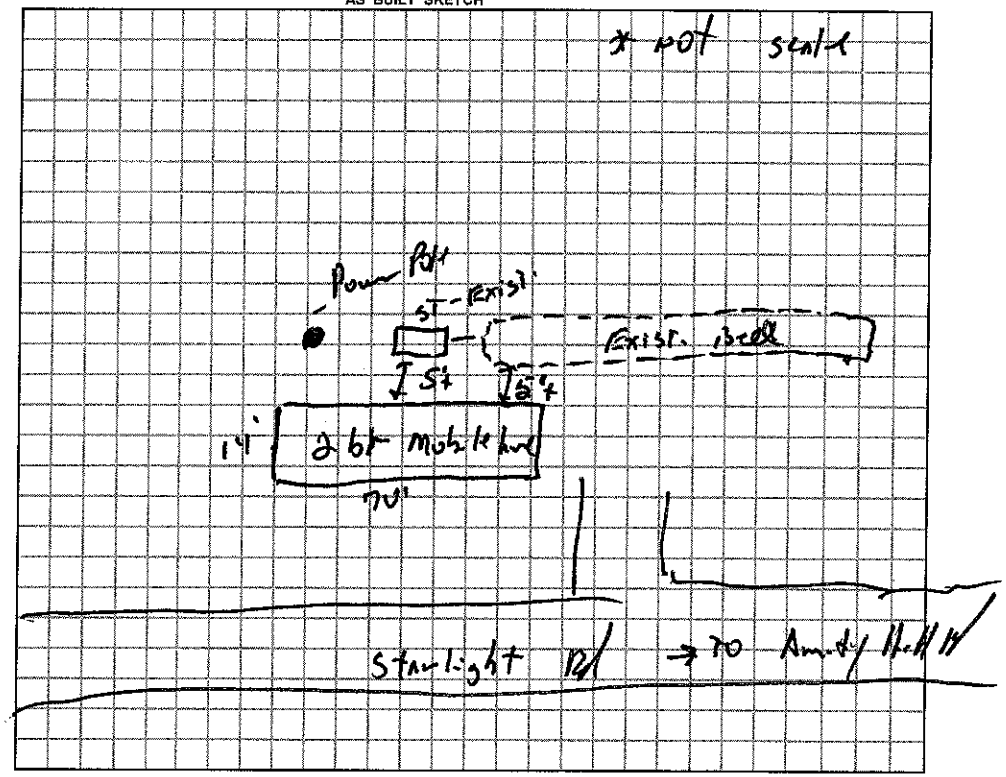

Permit can be suspended or revoked if any false information is supplied toward securing the permit / any unauthorized changes are made to the site / any unauthorized changes are made in the installation of the system.

☐ *IMPROVEMENT PERMIT w / plat valid without expiration.* ☐ *IMPROVEMENT PERMIT w / site plan valid for 60 mos.* ☐ *AUTHORIZATION TO CONSTRUCT valid for period equal to IMPROVEMENT PERMIT-not to exceed 60 mo.*

Owner / Applicant Signature: Ada Martin Date 8-31-2010

Improvement Permit by: Date

Authorization to Construct by: Date

YOU SHOULD CONTACT A LOCATOR SERVICE PRIOR TO ANY EXCAVATION.

Installed by:

Operation Permit by: Date:

Existing System Inspected by: Jim Haynes, RS Date: 31 August 10

WHITE COPY Environmental Health YELLOW COPY (Final) Owner / Applicant PINK COPY (Initial) Owner / Applicant