Abernathy, Deloure

47883

IREDELL COUNTY HEALTH DEPARTMENT

STATESVILLE 704-878-5305 MOORESVILLE 704-664-5281

IMPROVEMENT PERMIT / CERTIFICATE OF COMPLETION / OPERATION PERMIT / EXISTING SYSTEM INSPECTION

DATE 7-2-93 TAX MAP NO. 5B-1-A-70

PROPERTY DESCRIPTION NO. 16326 PHONE: Business 872 6666 Home Same

OWNER OR CONTRACTOR Rosa Bustle

ADDRESS Rt 7 Box 562 Statesville

LOCATION I-77 S TL Amity Hill Rd 3mi on Rt across from staglite Lake

SUBDIVISION BLOCK / SECTION LOT LOT AREA 200X200 SITE CLASS. P.S. L.T.A.R. .4

Water Supply: ☑ Individual ☐ Community ☐ Public

Septic Tank: 1250 Gallons: STB 564 Date 6-13-92

Pump Tank: Gallons: PT Date

Nitrification Field: No Fields 1 Square Feet 1200 Linear Feet 400

No Lines 3 Trench Width 36 Trench Depth 24 Gravel Depth 12

☑ New System ☐ Repair System Type: I, II, III, IV, V, VI

System Description: Conv. Gravity

Repair System Description: "

Maintenance Agreement Required: ☐ Yes ☑ No

☑ House/Mod. Home ☐ Mobile Home ☐ Business ☐ Other

No. Bedrooms 4 No. Bathrooms 3 No. Employees

☐ Slab ☐ Crawl Space ☑ Basement w/plumbing ☐ Basement wo/plumbing

Garbage Disposal. ☐ Yes ☑ No


Auto. Dishwasher: ☐ Yes ☑ No

Auto. Washing Machine: ☑ Yes ☐ No


Other

Comments

INITIAL SITE SKETCH

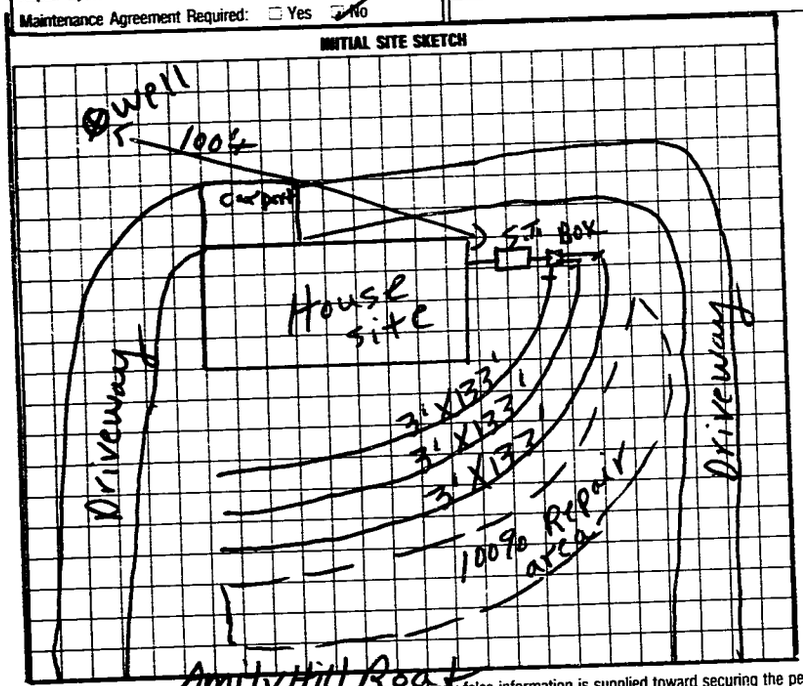

AS BUILT SKETCH

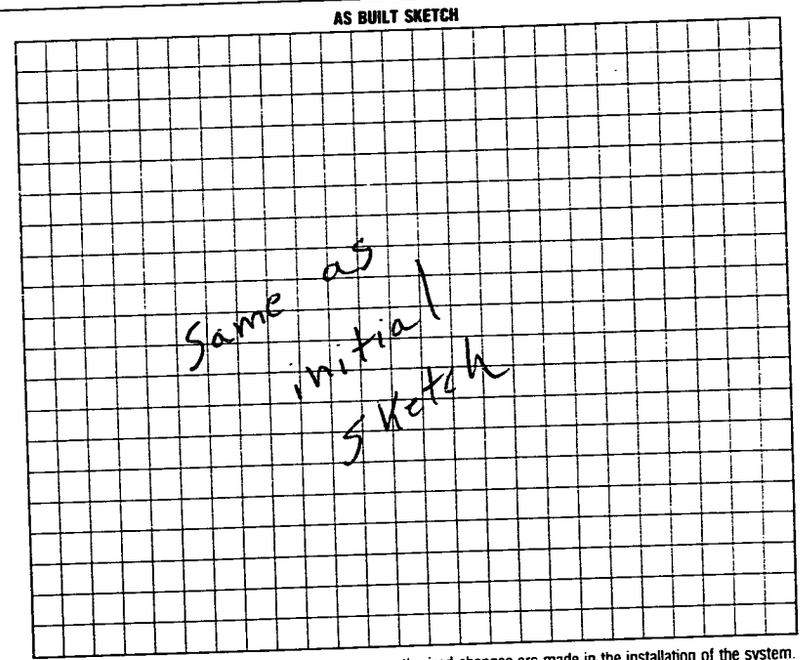

I understand that this permit can be suspended or revoked if any false information is supplied toward securing the permit/any unauthorized changes are made to the site/any unauthorized changes are made in the installation of the system. Improvement Permit is valid for 60 months from date of issuance.

Signed: x Kenneth M Cline Agent

Improvement Permit by: L. C. moore date 7-2-93

Existing System Inspection by: date

Installed by: James Hutlck

Certificate of Completion by: L. C. moore date 10-1-93

Operation Permit by: date

HEALTH DEPT. COPY: WHITE INSPECTION COPY (FINAL): GREEN OWNER COPY (FINAL): YELLOW INSPECTION COPY (INITIAL): PINK OWNER COPY (INITIAL): GOLD