IREDELL COUNTY HEALTH DEPARTMENT

STATESVILLE 704-878-5305 MOORESVILLE 704-664-5281

IMPROVEMENT PERMIT / AUTHORIZATION TO CONSTRUCT / OPERATION PERMIT / EXISTING SYSTEM INSPECTION

PERMIT# 132759 PIN# 4751921452 Greg Pate DATE 1-6-06

OWNER OR APPLICANT Freedom Homes / Mary Bryant PHONE: Business 528-7960 Home (Freedom) 433-1828

ADDRESS 1042 Charlotte Hwy / Trautman, NC 28166

LOCATION Hwy 21 North TR Oswalt Amity Rd ~ 4 miles on right Gladiola Rd at end #137

SUBDIVISION _____ BLOCK / SECTION _____ LOT _____ LOT AREA 1A acreage SITE CLASS PS DESIGN FLOW 360gpd L.T.A.R. _____

Septic Tank: 1000 Gallons; STB _____ Date _____

Pump Tank: _____ Gallons; PT _____ Date _____

Pump Make: _____ Model _____ Serial No. _____

Notification Field: No. Fields 1 Square Feet 720 Linear Feet 240

No Lines 3 Trench Width 36" Max Trench Bottom Depth — Gravel Depth 12"

☐ New System ☐ Repair ☐ Expansion System Type: ☐ I ☐ II ☐ III ☐ IV ☐ V ☐ VI

System Description: Existing Gravity-Convent

Repair System Description: _____

Maintenance Agreement Required: ☐ Yes ☒ No

☐ House/Mod. Home ☒ Mobile Home ☐ Business ☐ Other

No. Bedrooms 3 No. Persons ___ No. Employees ___


Water Supply: ☒ Individual ☐ Public ☐ Community

☐ Slab ☒ Crawl Space ☐ Basement w/plumbing ☐ Basement wo/plumbing

Comments:/Conditions:

Comments:/Conditions: Existing Septic System Appears to be functioning okay at time of inspection.

INITIAL SITE SKETCH ★ Not to Scale

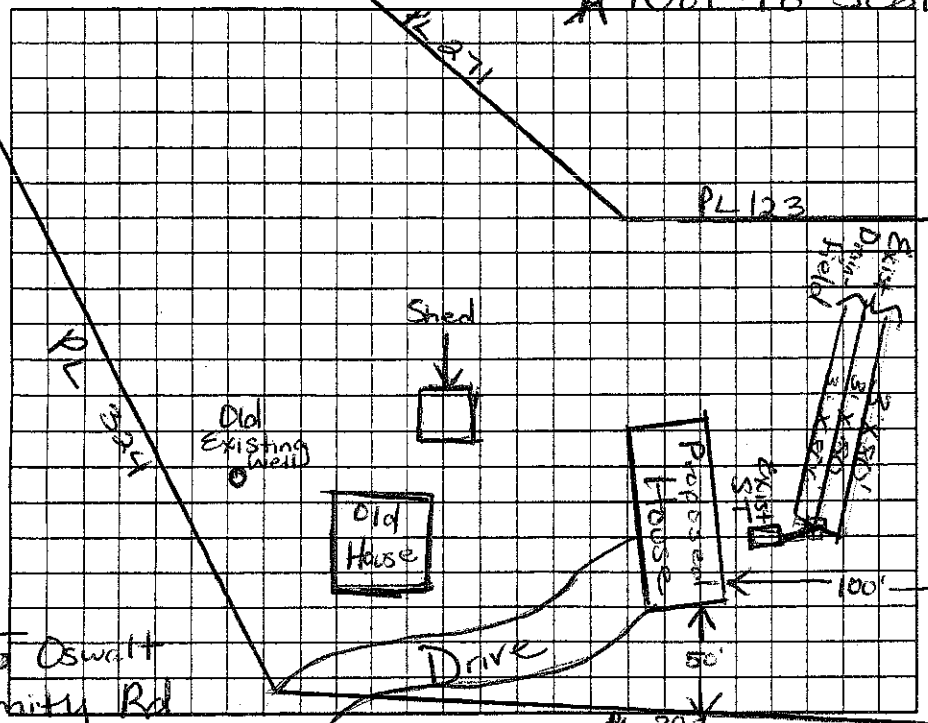

AS BUILT SKETCH

Septic System originally designed for 3 Bedroom home in 1983. Okay to set up 3 Bedroom house. Original permit attached.

Permit can be suspended or revoked if any false information is supplied toward securing the permit/any unauthorized changes are made to the site/any unauthorized changes are made in the installation of the system. Improvement Permit with plat valid without expiration ☐ Improvement Permit with site plan valid for sixty months ☐ Authorization to Construct is valid for a period equal to that of Improvement Permit – not to exceed sixty months.

Signed: Brenda Logan date 1-9-06

Improvement Permit by: Marvin H. Dotson RS date 1/6/06

Authorization to Construct by: Marvin H. Dotson RS date 1/6/06

Installed by: _____

Operation Permit by: _____ date _____

Existing System Inspection by: Marvin H. Dotson RS date 4/3/06

HEALTH DEPT. COPY: WHITE OWNER COPY (FINAL): YELLOW OWNER COPY (INITIAL): PINK