IREDELL COUNTY HEALTH DEPARTMENT

STATESVILLE 704-878-5305 MOORESVILLE 704-664-5281

IMPROVEMENT PERMIT / AUTHORIZATION TO CONSTRUCT / OPERATION PERMIT / EXISTING SYSTEM INSPECTION

PERMIT# 137680 PIN# ~~4761-12-2089~~ 4751-92-7163 DATE 8/31/06

OWNER OR APPLICANT Peter + Donna Snyder PHONE: Business _____ Home _____

ADDRESS 150 Berachah Pl Mooresville NC

LOCATION 115N, TR Shinnville, TL Weathers Creek, TL Ticetop, on Rt

SUBDIVISION Oak Ridge BLOCK / SECTION _____ LOT 18 LOT AREA 2.165 AC SITE CLASS. PS DESIGN FLOW 360 L.T.A.R. 0.3

Septic Tank: 1000 Gallons: STB 794 Date 2-2-07
Pump Tank: _____ Gallons: PT _____ Date _____
Pump Make: _____ Model _____ Serial No. 300'AC
Nitrification Field: No Fields ___ Square Feet 1200 Linear Feet 400
No Lines 4 Trench Width 36" Max Trench Bottom Depth 36"

☒ New System ☐ Repair ☐ Expansion System Type: I (II) III IV V VI
System Description: Conventional
Repair System Description: S9 ME
Maintenance Agreement Required: ☐ Yes ☒ No

☒ House/Mod. Home No. Bedrooms 3
☐ Mobile Home No. Persons ___
☐ Business No. Employees ___
☐ Other _____


Water Supply: ☒ Individual ☐ Public ☐ Community

Gravel Depth 12" ☒ Gravity ☐ Pressure ☐ Slab ☐ Crawl Space ☐ Basement w/plumbing ☒ Basement wo/plumbing

Comments:/Conditions:

Comments:/Conditions:


INITIAL SITE SKETCH

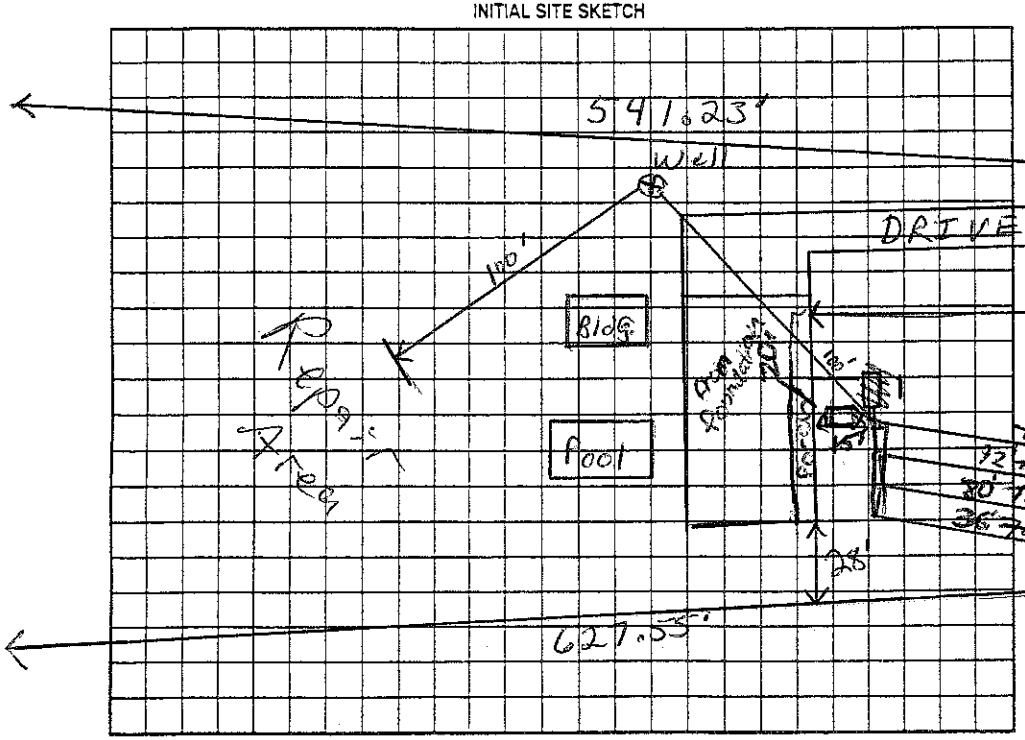

AS BUILT SKETCH

End Cap Drop downs

Tank 20' from house foundation.

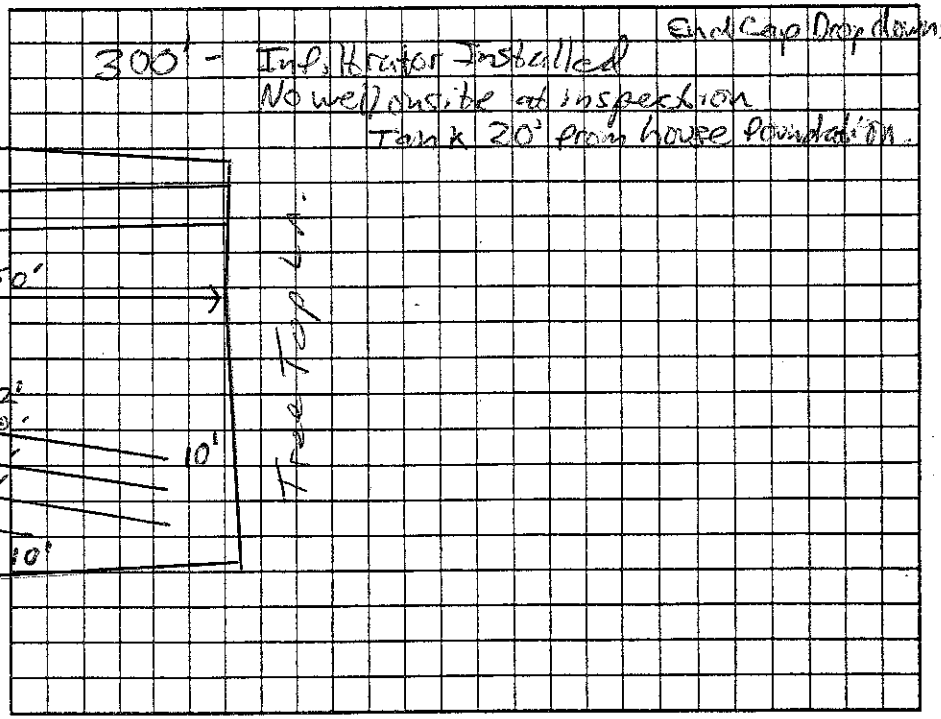

Permit can be suspended or revoked if any false information is supplied toward securing the permit/any unauthorized changes are made to the site/any unauthorized changes are made in the installation of the system. Improvement Permit with plat valid without expiration ☐ Improvement Permit with site plan valid for sixty months ☐ Authorization to Construct is valid for a period equal to that of Improvement Permit – not to exceed sixty months.

Signed: [signature] 9-21-06 date _____

Improvement Permit by: [signature] RS date 8/31/06

Authorization to Construct by: [signature] RS date 8/31/06

Installed by: Tucker's Hauling & Grading

Operation Permit by: Anthony Cobern date 8/14/07

Existing System Inspection by: _____ date _____

HEALTH DEPT. COPY: WHITE OWNER COPY (FINAL): YELLOW OWNER COPY (INITIAL): PINK