4751927868

IREDELL COUNTY HEALTH DEPARTMENT

STATESVILLE 704-878-5305 MOORESVILLE 704-664-5281

IMPROVEMENT PERMIT / CERTIFICATE OF COMPLETION / OPERATION PERMIT / EXISTING SYSTEM INSPECTION

PROPERTY DESCRIPTION NO. 16122 DATE 8/31/93 TAX MAP NO. 5B A56

OWNER OR CONTRACTOR JL COWAN PHONE: Business Home 528-5121

ADDRESS

LOCATION Oswalt Quicky Rd, (R) off 115N to on (R) just before County Hill Rd. on (L), behind house

SUBDIVISION N/A BLOCK / SECTION LOT LOT AREA SITE CLASS. L.T.A.R. 3-.35

Water Supply: ☑ Individual ☐ Community ☐ Public above house

Septic Tank: 1000 Gallons; STB 825 Date 6-11-93

Pump Tank: Gallons; PT Date

Nitrification Field: No Fields 1 Square Feet 900 Linear Feet 300

No Lines 3 Trench Width 36" Trench Depth 36" Gravel Depth 12"

☑ New System ☐ Repair System Type: I, (II), III, IV, V, VI

System Description: CONV

Repair System Description: Pres-Conv.

Maintenance Agreement Required: ☐ Yes ☑ No

☑ House/Mod. Home No. Bedrooms 3 Garbage Disposal: ☐ Yes ☐ No

☐ Mobile Home No. Bathrooms 2 Auto. Dishwasher: ☐ Yes ☐ No

☐ Business No. Employees Auto. Washing Machine: ☐ Yes ☐ No

☐ Other Other


☐ Slab ☐ Crawl Space ☐ Basement w/plumbing ☐ Basement wo/plumbing

Comments 3 c 2 - 5 Saprolite

Step downs used as shown.

INITIAL SITE SKETCH

AS BUILT SKETCH

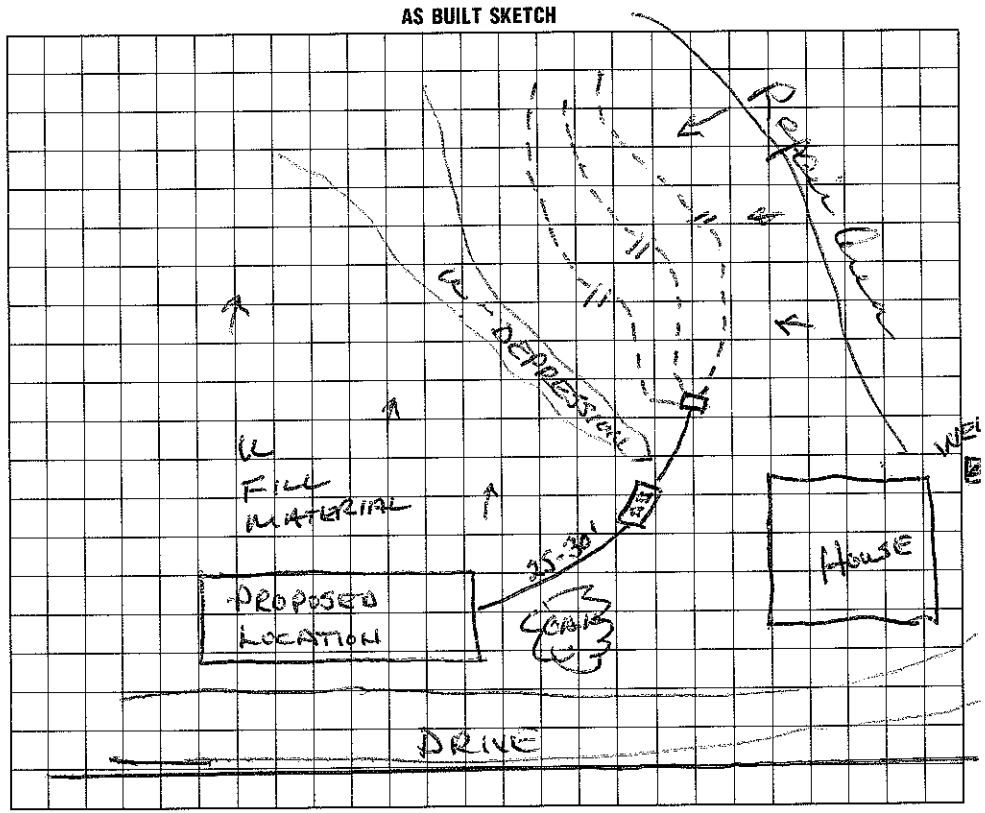

I understand that this permit can be suspended or revoked if any false information is supplied toward securing the permit/any unauthorized changes are made to the site/any unauthorized changes are made in the installation of the system. Improvement Permit is valid for 60 months from date of issuance.

Signed:

Improvement Permit by: date

Existing System Inspection by: date

Installed by: Curtis Gibson

Certificate of Completion by: Wesley Sparks RS. date 8/31/93

Operation Permit by: date

HEALTH DEPT. COPY: WHITE INSPECTION COPY (FINAL): GREEN OWNER COPY (FINAL): YELLOW INSPECTION COPY (INITIAL): PINK OWNER COPY (INITIAL): GOLD