IREDELL COUNTY HEALTH DEPARTMENT

Statesville Office (704) 878-5305 Mooresville Office (704) 660-3625 PERMIT # 213910

IMPROVEMENT PERMIT / AUTHORIZATION TO CONSTRUCT / OPERATION PERMIT / EXISTING SYSTEM

PIN # 4751953957

APPLICANT: William Perry APPLICANT ADDRESS: 350 Hoots Ln.

SITE ADDRESS: 3657 Amity Hill Rd. PHONE: 704-431-9888 ALT. PHONE: N/A

SITE DIRECTIONS: Hwy 115 TL Amity Hill Rd Property on Left ~3 miles after crossing I-77

SUBDIVISION: N/A SECTION: N/A LOT # N/A LOT AREA: 2.5 acres DESIGN FLOW: 495 gpd L.T.A.R.: 0.25

Septic Tank 1000 (gal) STB 760 Date 4/15

Pump Tank (gal) PT Date

Pump Make Model Serial #

Nitrification Fields 1 # Lines 6 Linear Ft: 456'

Trench Width 36" Max. Trench Bottom Depth 36" Gravel Depth N/A

☑ New System ☐ Repair ☐ Expansion System Type: I II (III) IV V VI

System Description: 25% Reduction

Repair System Description: 50% Reduction

Maintenance Agreement Required: ☐ YES ☐ NO

☑ GRAVITY ☐ PRESSURE

☐ Residence No. Bedrooms 3

☐ Business No. Persons

☑ Other Beauty Shop 1 Chair No. Employees

☐ Slab ☑ Crawl Space


☐ Basement w/plumbing ☐ Basement w/o plumbing

Water Supply: ☑ Private ☐ Public ☐ Community


Comments / Conditions: IMPROVEMENTS ONLY!! Submit floor plan prior to issuance of CA. Install a 25% Reduction system on contour with serial distribution.

Install a surface diversion berm up slope of nitrification field. Design is for a 3BR SFD with a 1 Chair beauty shop

INITIAL SITE SKETCH

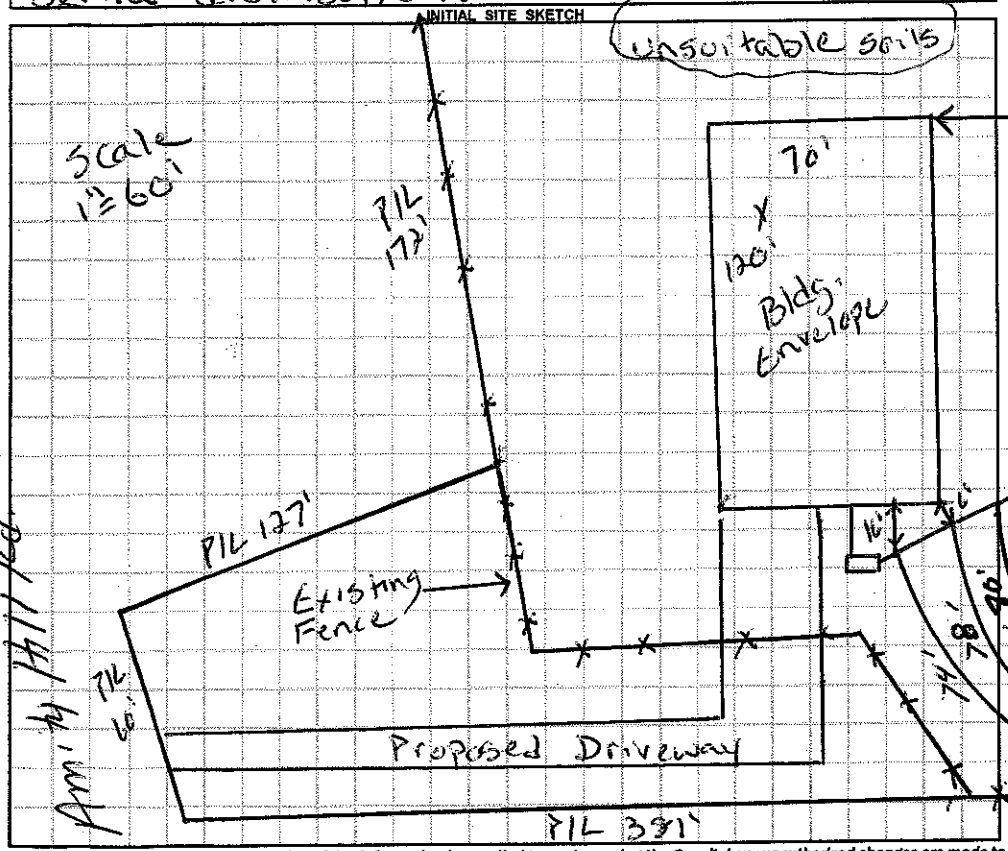

AS BUILT SKETCH

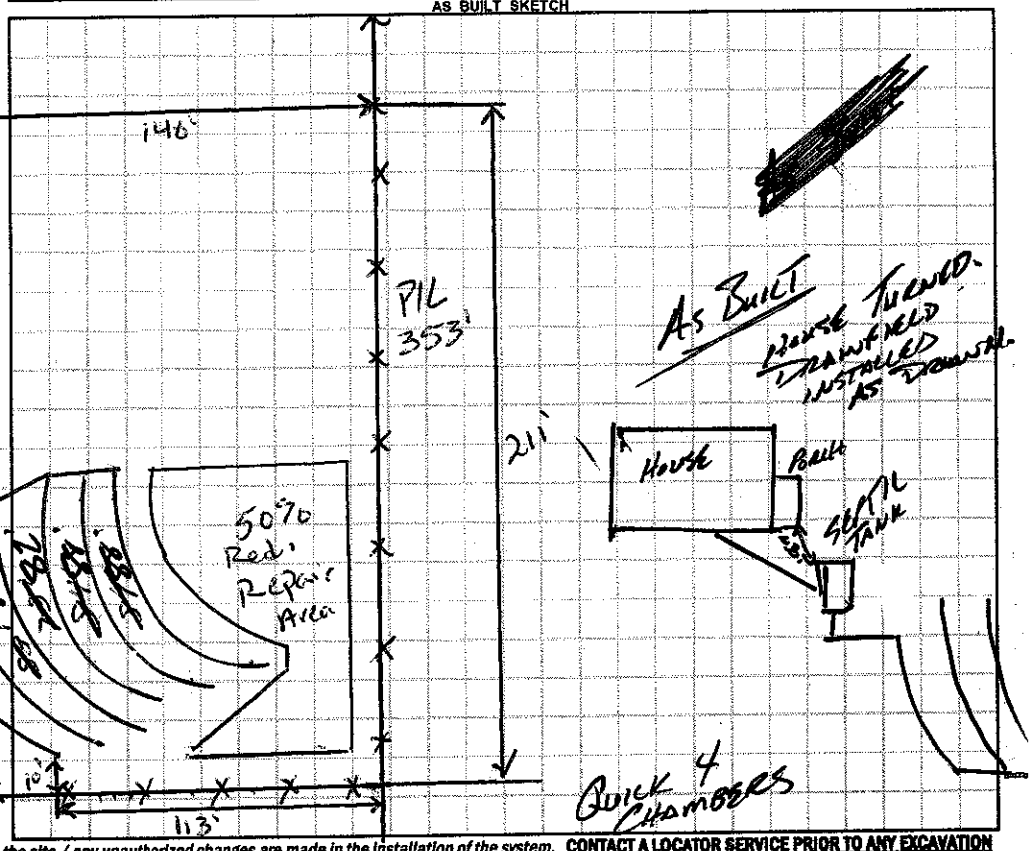

Permit can be suspended or revoked if any false information is supplied toward securing the permit / any unauthorized changes are made to the site / any unauthorized changes are made in the installation of the system. **CONTACT A LOCATOR SERVICE PRIOR TO ANY EXCAVATION**

☐ **IMPROVEMENT PERMIT** *with plat valid without expiration.* ☐ **IMPROVEMENT PERMIT** *with site plan valid for 60 mos.* ☑ **AUTHORIZATION TO CONSTRUCT** *valid for period equal to IMPROVEMENT PERMIT--not to exceed 60 mo.*

Owner / Applicant Signature: Will Perry Date: 10-27-15 Installed by: Al Backhoe

IMPROVEMENT PERMIT by: Justin O'Henderson Date: 10-15-15 OPERATION PERMIT by: Date: 8/3/16

AUTHORIZATION TO CONSTRUCT by: Justin O'Henderson Date: 11-24-15 Existing System Inspected by: Date:

Health Dept. Copy - WHITE Applicant (Final Approval) - YELLOW Applicant (Conditional Approval) - PINK