IREDELL COUNTY HEALTH DEPARTMENT

Statesville Phone TR 3-7271 — Mooresville Phone NO 3-1271

PERMIT TO INSTALL SEPTIC TANK

Permit NO. _____ Permit Date July 3, 1958

Owner HERMAN HOOVER Address RFD STATESVILLE

Installed By HOKE Address _____


Location of Property SWT AMITY HILL RD. CROSS NEW BY PASS 1ST HOUSE ON RIGHT AT BOTTOM OF HILL

Tank		Capacity		Length of Lines		Fixtures	
Block	( )	800	(✓)	150'	(✓)	No. of Baths	(1)
Precast	(✓)	900	( )	175'	( )	Dishwasher	( )
		1000	( )	200'	( )	Garbage Grdr.	( )
		1100	( )	225'	( )	Auto-Washer	( )
		1200	( )	250'	( )	Other	_____
		Other	_____	Other	_____		

NOTIFY HEALTH DEPARTMENT AT LEAST EIGHT HOURS BEFORE TANK IS TO BE INSPECTED.

Final Inspection July 3, 1958 Approved (✓) Disapproved ( )

Remarks _____

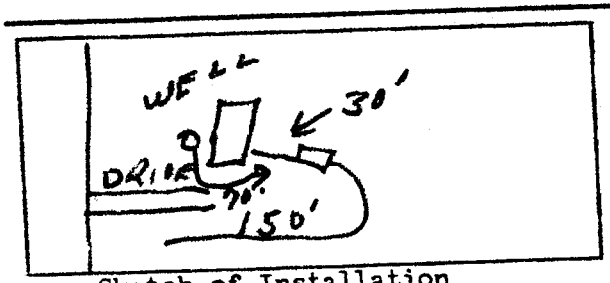

Sketch of Installation

Robert A. Thomas

Sanitarian