IREDELL COUNTY HEALTH DEPARTMENT

Statesville Phone TR 3-7271 Mooresville Phone NO 3-1271

PERMIT TO INSTALL SEPTIC TANK

Permit No. _____ Permit Date Sept 17 1964

Owner Bobbie Lefland Address Statesville

Installed By Ray Lunt Address Statesville


Location of Property Amity Hill rd. Third House On Right after cross By pass

Tank		Capacity		Length of Lines		Fixtures	
Block	( )	1000	(✓)	225'	(✓)	No. of Baths	(1½)
Precast	( )	1250	( )	250'	( )	Dishwasher	( )
Pond	—	1500	( )	Other _____		Garbage Grdr.	( )
		Other _____				Other _____	

NOTIFY HEALTH DEPARTMENT AT LEAST EIGHT HOURS BEFORE TANK IS TO BE INSPECTED.

Final Inspection 7-17 1964 Approved (✓) ~~Disapproved~~ ( )

Remarks Pond

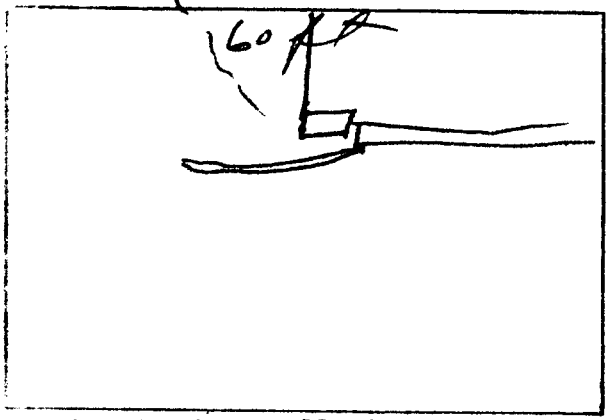

Sketch of Installation

Sanitarian