IREDELL COUNTY HEALTH DEPARTMENT

STATESVILLE 704-878-5305 MOORESVILLE 704-664-5281

IMPROVEMENT PERMIT / CERTIFICATE OF COMPLETION / OPERATION PERMIT / EXISTING SYSTEM INSPECTION

DATE 6-9-93 TAX MAP NO. 5D-A-6

PROPERTY DESCRIPTION NO. 16475 PHONE: Business 664-4466 Home 872-0156

OWNER OR CONTRACTOR Boyce C. Tucker Jr

ADDRESS Rt 4 Box 685-H Statesville N.C.

LOCATION I-77 South To Amity Hill To Dover Rd Just Past I-77 1/2 mi on Left

SUBDIVISION _____ BLOCK / SECTION _____ LOT _____ LOT AREA 3.76 acres SITE CLASS. P.S. L.T.A.R. .4

Water Supply: ☑ Individual ☐ Community ☐ Public

Septic Tank: 1000 Gallons; STB 1012 Date 4-27-93

Pump Tank: _____ Gallons; PT _____ Date _____

Nitrification Field: No Fields 1 Square Feet 900 Linear Feet 300

No Lines 3 Trench Width 36 Trench Depth 24 Gravel Depth 12

☑ New System ☐ Repair System Type: I, II, III, IV, V, VI

System Description: conv. Gravity

Repair System Description: _____

Maintenance Agreement Required: ☐ Yes ☑ No

☐ House/Mod. Home ☑ Mobile Home ☐ Business ☐ Other _____

No. Bedrooms 3 No. Bathrooms 2 No. Employees _____

☐ Slab ☑ Crawl Space ☐ Basement w/plumbing ☐ Basement wo/plumbing

Garbage Disposal: ☐ Yes ☑ No


Auto. Dishwasher: ☐ Yes ☐ No

Auto. Washing Machine: ☐ Yes ☐ No


Other _____

Comments Existing wells located on back of acreage Tract over 100' from areas of S.T. system

INITIAL SITE SKETCH

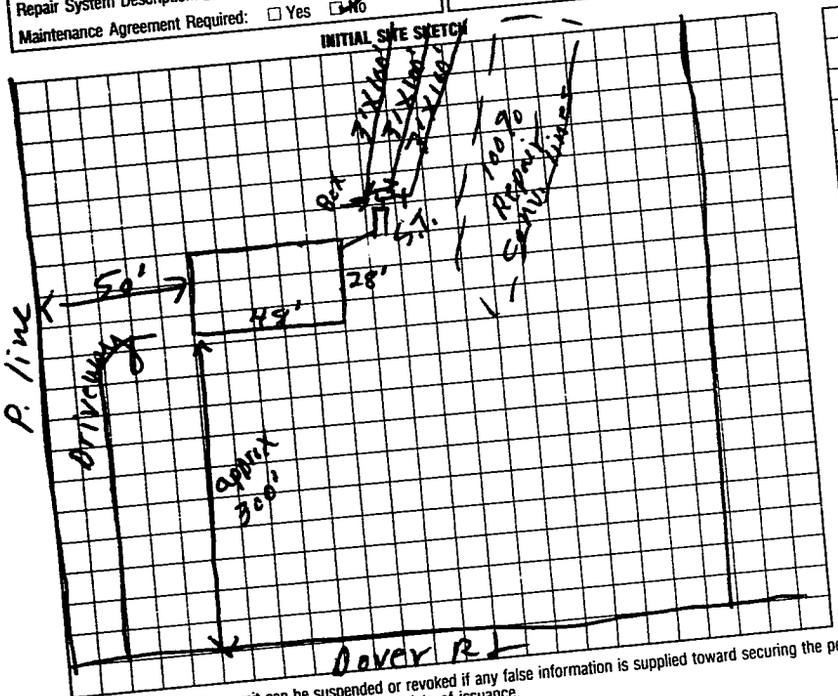

AS BUILT SKETCH

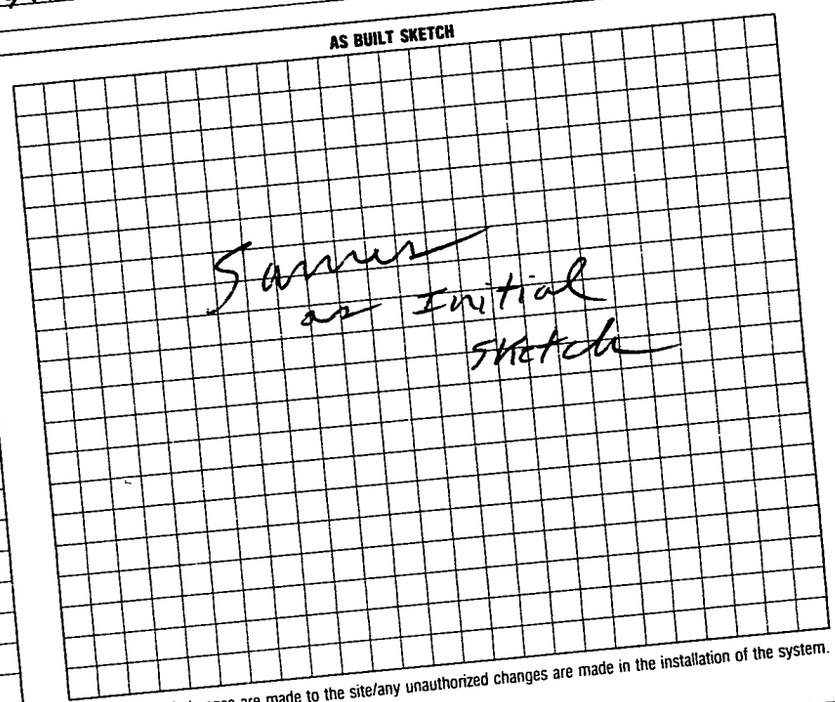

I understand that this permit can be suspended or revoked if any false information is supplied toward securing the permit/any unauthorized changes are made to the site/any unauthorized changes are made in the installation of the system. Improvement Permit is valid for 60 months from date of issuance.

Signed: Boyce C Tucker date 6-9-93

Improvement Permit by: E.C. Moore date _____

Existing System Inspection by: _____ date _____

Installed by: Kenny Pearson

Certificate of Completion by: E.C. Moore date 7-15-93

Operation Permit by: _____ date _____

HEALTH DEPT. COPY: WHITE INSPECTION COPY (FINAL): GREEN OWNER COPY (FINAL): YELLOW INSPECTION COPY (INITIAL): PINK OWNER COPY (INITIAL): GOLD