IREDELL COUNTY HEALTH DEPARTMENT

STATESVILLE 704-878-5305 MOORESVILLE 704-664-5281

IMPROVEMENT PERMIT / AUTHORIZATION TO CONSTRUCT / OPERATION PERMIT / EXISTING SYSTEM INSPECTION

PERMIT# 091433 PIN# 4752 11 2195 DATE 8-21-00

OWNER OR CONTRACTOR DENNIS E. BASS PHONE: Business Home 871-9991

ADDRESS 3113 AMITY HILL RD, STATESVILLE, NC 28677

LOCATION AMITY HILL ROAD, SOUTH, 3RD DRIVEWAY ON LEFT PAST CREEK @ #3113

SUBDIVISION BLOCK / SECTION LOT 7 LOT AREA 11.8 ACRES SITE CLASS PS DESIGN FLOW 360 L.T.A.R. 0.4 GPD/FT²

Septic Tank: EXISTING Gallons; STB Date

Pump Tank: Gallons; PT Date

Pump Make: Model Serial No.

Nitrification Field: No Fields Square Feet Linear Feet EXISTING

No Lines Trench Width Max Trench Bottom Depth

☑ New System ☐ Repair System Type: I II III IV V VI

System Description: CONVENTIONAL GRAVITY

Repair System Description: CONV. GRAVITY

Maintenance Agreement Required: ☐ Yes ☑ No

Gravel Depth 12"

☐ Slab ☑ Crawl Space ☐ Basement w/plumbing ☐ Basement wo/plumbing

☐ House/Mod. Home No. Bedrooms 3

☑ Mobile Home No. Bathrooms 2

☐ Business No. Employees


☐ Other

Water Supply: ☑ Individual ☐ Public ☐ Community WELL

Comments/Conditions: EXPOSE SEPTIC TANK LID, REINFORCE WITH REBAR & CONCRETE IF GREATER THAN 36" DEEP. EXTEND CONCRETE RISERS TO GROUND SURFACE

Comments/Conditions:

INITIAL SITE SKETCH

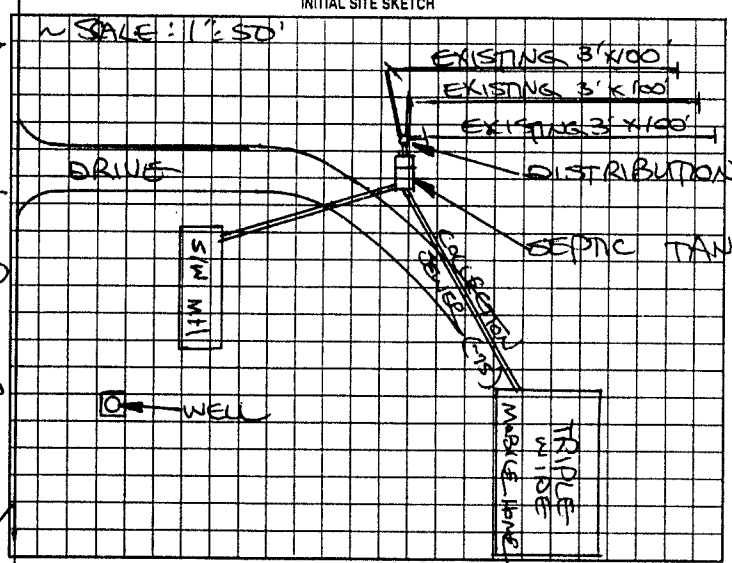

AS BUILT SKETCH

SEPTIC TANK EXPOSED TO WITHIN 6 INCHES OF SURFACE - PUMPED OUT.

AMITY HILL ROAD (SR 2342)

Permit can be suspended or revoked if any false information is supplied toward securing the permit/any unauthorized changes are made to the site/any unauthorized changes are made in the installation of the system. Improvement Permit with plat valid without expiration. Improvement Permit with site plan valid for sixty months. Authorization to Construct is valid for a period equal to that of Improvement Permit – not to exceed sixty months.

Signed: date 5-22-01 Installed by: OPENED BY OWNER

Improvement Permit by: STEVE HEDRICK date 8-21-00 Operation Permit by: STEVE HEDRICK date 3-12-01

Authorization to Construct by: STEVE HEDRICK date 8-21-00 Existing System Inspection by: date

HEALTH DEPT. COPY: WHITE OWNER COPY (FINAL): YELLOW OWNER COPY (INITIAL): PINK