IREDELL COUNTY HEALTH DEPARTMENT

STATESVILLE 704-878-5305 MOORESVILLE 704-664-5281

IMPROVEMENT PERMIT / AUTHORIZATION TO CONSTRUCT / OPERATION PERMIT / EXISTING SYSTEM INSPECTION

PERMIT# 102251 20 PIN# 4752 10 6481 DATE 9/17/01

OWNER OR CONTRACTOR Allen & Wilma McPhee PHONE: Business _____ Home 704-873-7410

ADDRESS 3153 County Hill Rd. Statesville, NC. 28677

LOCATION County Hill Rd. on (L) side of # 3153

SUBDIVISION No BLOCK / SECTION _____ LOT _____ LOT AREA 1 Ac SITE CLASS. P5 DESIGN FLOW 240 L.T.A.R. .3

Septic Tank: 1000 Gallons; STB 1012 Date 4/26/01
Pump Tank: _____ Gallons; PT _____ Date _____
Pump Make: _____ Model _____ Serial No. _____
Nitrification Field: No Fields 1 Square Feet 800 Linear Feet 267
No Lines 2@133 Trench Width 3' Max Trench Bottom Depth 3' Gravel Depth 12"

[X] New System ☐ Repair System Type: I, II, III, IV, V, VI
System Description: GRAV. CONVENTIONAL
Repair System Description: SAME
Maintenance Agreement Required: ☐ Yes [X] No

[X] House/Mod. Home No. Bedrooms 2
☐ Mobile Home No. Bathrooms 2
☐ Business No. Employees _____
☐ Other _____
☐ Slab [X] Crawl Space ☐ Basement w/plumbing ☐ Basement wo/plumbing


Water Supply:
[X] Individual
☐ Public
☐ Community
LOG HOUSES.

Comments:/Conditions:


Comments:/Conditions:

INITIAL SITE SKETCH

(1"=40')

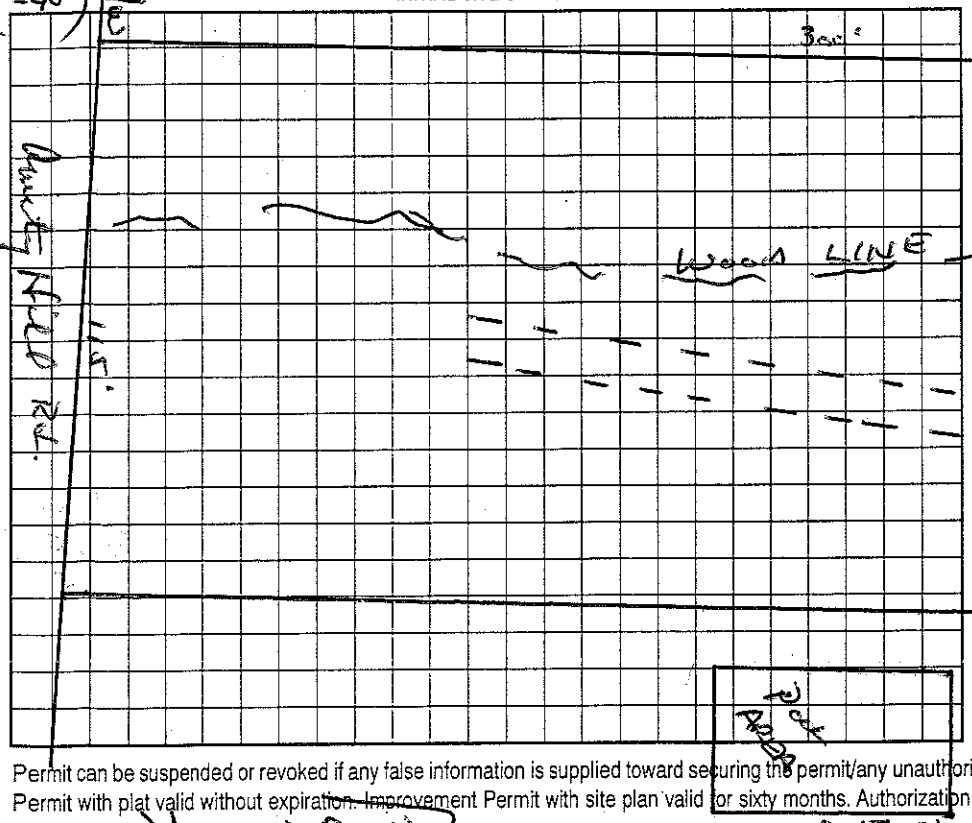

AS BUILT SKETCH

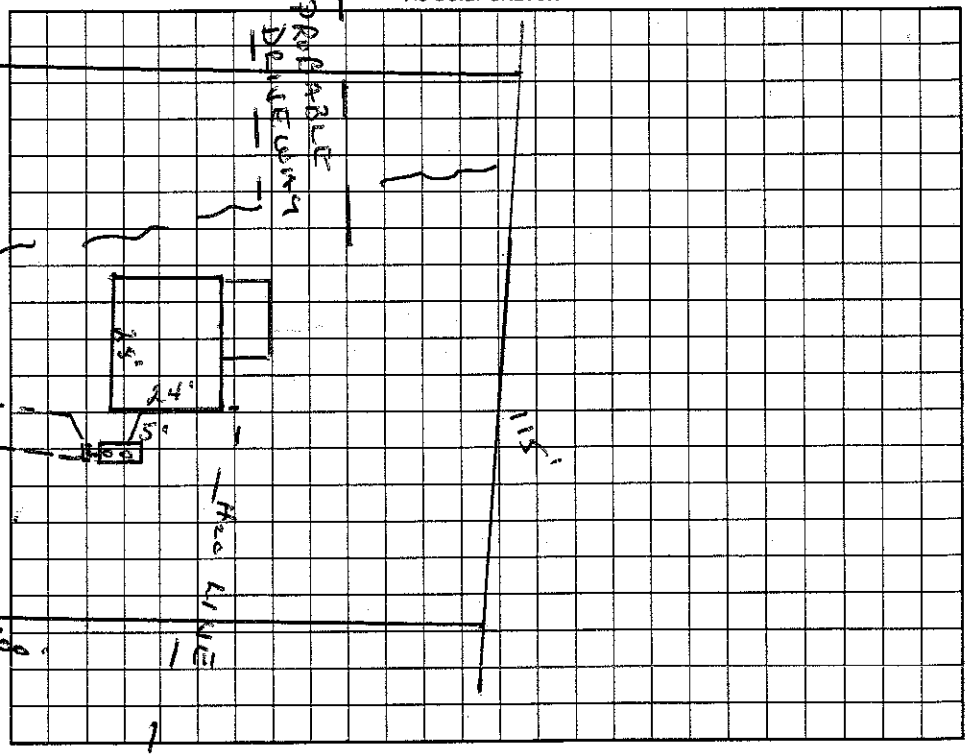

Permit can be suspended or revoked if any false information is supplied toward securing the permit/any unauthorized changes are made to the site/any unauthorized changes are made in the installation of the system. Improvement Permit with plat valid without expiration. Improvement Permit with site plan valid for sixty months. Authorization to Construct is valid for a period equal to that of Improvement Permit – not to exceed sixty months.

Signed: [signature] date 9-17-01

Improvement Permit by: Wesley Sparks RS. date 9/17/01

Authorization to Construct by: Wesley Sparks RS date 9/17/01

Installed by: Steve Jordan

Operation Permit by: Wesley Sparks RS date 9/28/01

Existing System Inspection by: _____ date _____

HEALTH DEPT. COPY: WHITE OWNER COPY (FINAL): YELLOW OWNER COPY (INITIAL): PINK