IREDELL COUNTY HEALTH DEPARTMENT

STATESVILLE 704-878-5305 MOORESVILLE 704-664-5281

IMPROVEMENT PERMIT / AUTHORIZATION TO CONSTRUCT / OPERATION PERMIT / EXISTING SYSTEM INSPECTION

PERMIT# 119372 PIN# 4752-10-5495 DATE 4/14/04

OWNER OR CONTRACTOR Allen and Wilma McPhee PHONE: Business 1-800-469-8262 Home 704-873-7410

ADDRESS 3145 Amity Hill Rd. Statesville, NC 28677

LOCATION I-77S Exit 45 ⓒ off Exit (Amity Hill Rd) Property ~1 mi on left

SUBDIVISION _____ BLOCK / SECTION _____ LOT _____ LOT AREA _____ SITE CLASS. PS DESIGN FLOW 240 L.T.A.R. Existing

Septic Tank: Existing 1000 Gallons; STB _____ Date _____

Pump Tank: _____ Gallons; PT _____ Date _____

Pump Make: _____ Model _____ Serial No. _____

Nitrification Field: No Fields 1 Square Feet 800 Linear Feet 267

No Lines 2 Existing Trench Width 36" Max Trench Bottom Depth 36" Gravel Depth 12"

☐ New System ☐ Repair System Type: I, ⓘ III, IV, V, VI

System Description: Conventional Gravity

Repair System Description: Same

Maintenance Agreement Required: ☐ Yes ☑ No

☑ House/Mod. Home No. Bedrooms 2

☐ Mobile Home No. Bathrooms 2

☐ Business No. Employees _____

☐ Other _____

☐ Slab ☑ Crawl Space ☐ Basement w/plumbing ☐ Basement wo/plumbing

Water Supply: ☑ Individual ☐ Public ☐ Community


Log House

Comments:/Conditions: ③ ⑤ Supply line from new house site must have an 18" clearance where they cross, with the potable source line OVER the sewer line.

Comments:/Conditions: ① System functioning properly at time of inspection ② Permission given to construct proposed structure ③ New structure shall not increase the number of bedrooms required for this system. ④ This is a visual inspection only and no guarantee problems will not arise in the future. CS

INITIAL SITE SKETCH

AS BUILT SKETCH (Scale 1"=40')

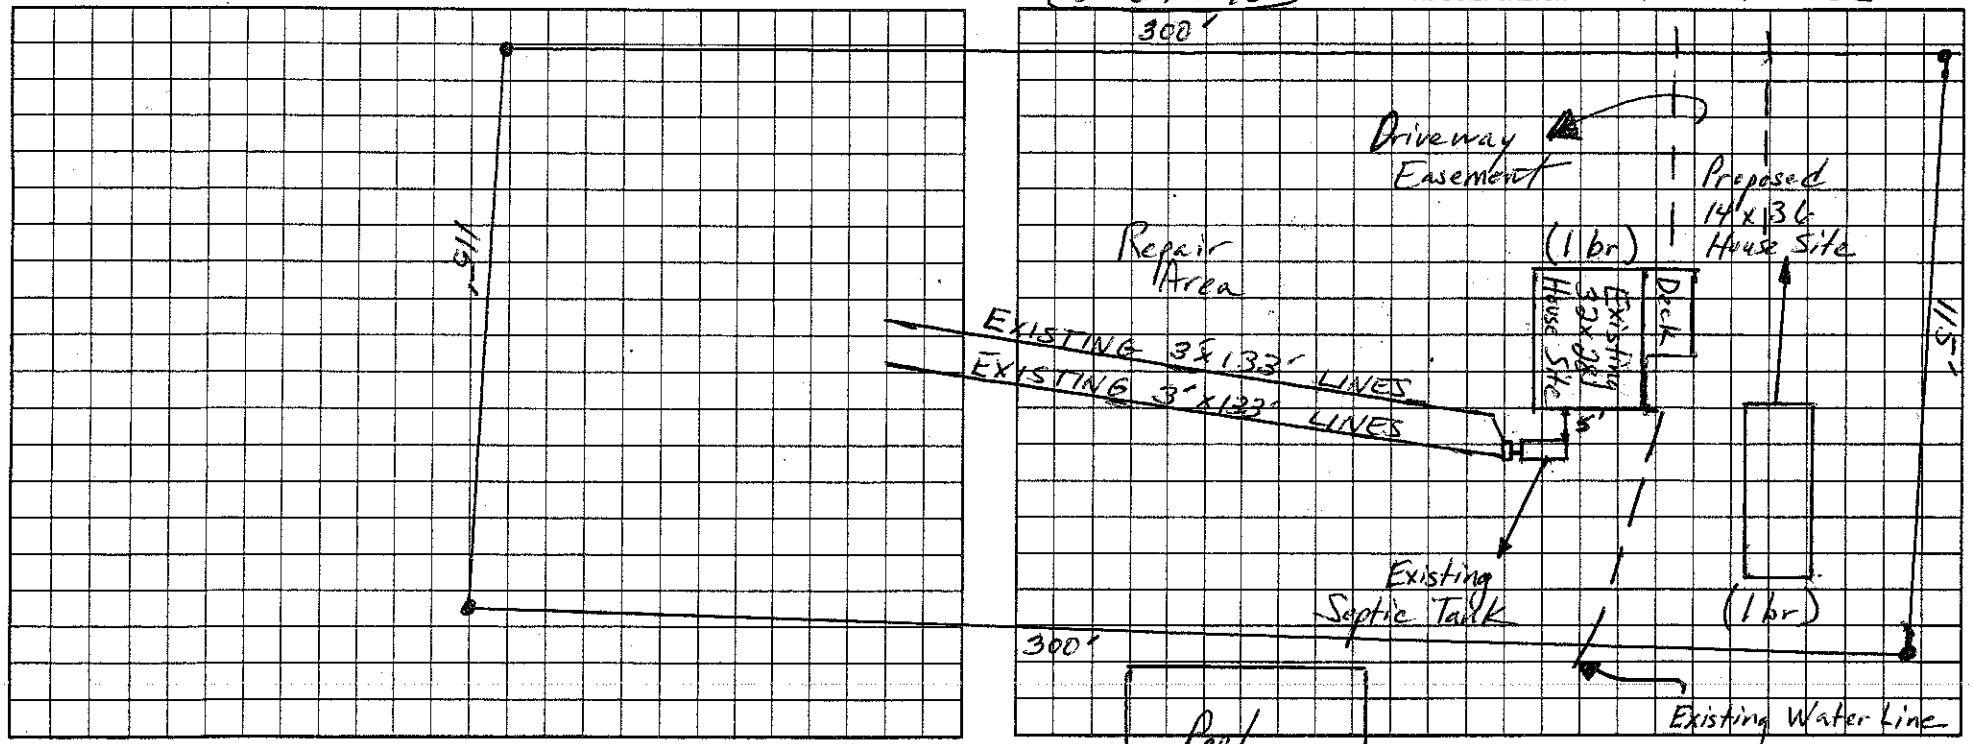

Permit can be suspended or revoked if any false information is supplied toward securing the permit/any unauthorized changes are made to the site/any unauthorized changes are made in the installation of the system. Improvement Permit with plat valid without expiration. Improvement Permit with site plan valid for sixty months. Authorization to Construct is valid for a period equal to that of Improvement Permit – not to exceed sixty months.

Signed: Allen R McPhee date 4-14-04 Installed by: Steve Jordan

Improvement Permit by: _____ date _____ Operation Permit by: _____ date _____

Authorization to Construct by: _____ date _____ Existing System Inspection by: Christopher M. Sherrill, RS date 4-14-04

HEALTH DEPT. COPY: WHITE OWNER COPY (FINAL): YELLOW OWNER COPY (INITIAL): PINK