46566

IREDELL COUNTY HEALTH DEPARTMENT

STATESVILLE 704-878-5305 MOORESVILLE 704-664-5281

IMPROVEMENT PERMIT / CERTIFICATE OF COMPLETION / OPERATION PERMIT / EXISTING SYSTEM INSPECTION

PROPERTY DESCRIPTION NO. 15895 DATE 8-3-93 TAX MAP NO. 5A-A-38B

OWNER OR CONTRACTOR Allen R. McPhee PHONE: Business Home

ADDRESS

LOCATION I-77 S TO Amity Hill Rd 1mi on left (10th House)

SUBDIVISION BLOCK / SECTION LOT LOT AREA 2.065 acres SITE CLASS. P.S. L.T.A.R. .3

Water Supply: ☑ Individual ☐ Community ☐ Public

Septic Tank: 1000 Gallons; STB 358 Date 5-3-93

Pump Tank: Gallons; PT Date

Nitrification Field: No Fields 1 Square Feet 810 Linear Feet 270

No Lines 3 Trench Width 36 Trench Depth 36 Gravel Depth 12

☑ New System ☐ Repair System Type: I, II, III, IV, V, VI

System Description: Conv. Gravity

Repair System Description:

Maintenance Agreement Required: ☐ Yes ☑ No

☑ House/Mod. Home ☐ Mobile Home ☐ Business ☐ Other

No. Bedrooms 3 No. Bathrooms 1½ No. Employees

☐ Slab ☑ Crawl Space ☐ Basement w/plumbing ☐ Basement wo/plumbing

Garbage Disposal: ☐ Yes ☑ No

Auto. Dishwasher: ☐ Yes ☑ No


Auto. Washing Machine: ☐ Yes ☐ No

Other

Comments

INITIAL SITE SKETCH

REPAIR AS BUILT SKETCH

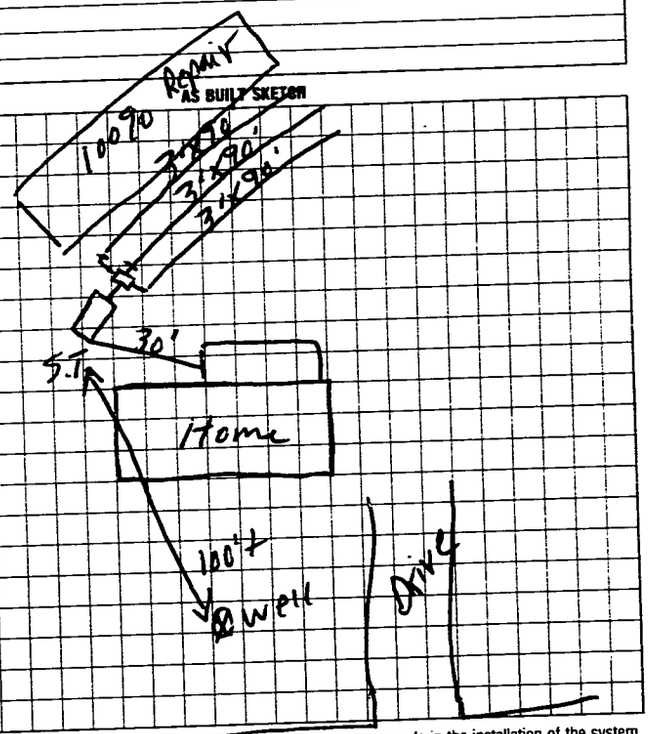

I understand that this permit can be suspended or revoked if any false information is supplied toward securing the permit/any unauthorized changes are made to the site/any unauthorized changes are made in the installation of the system. Improvement Permit is valid for 60 months from date of issuance.

Amity Hill Rd

Signed:

Improvement Permit by: J.C. moore date 7-2-93

Existing System Inspection by: date

Installed by: J.C. Forsyth

Certificate of Completion by: J.C. moore date 8-3-93

Operation Permit by: date

HEALTH DEPT. COPY: WHITE INSPECTION COPY (FINAL): GREEN OWNER COPY (FINAL): YELLOW INSPECTION COPY (INITIAL): PINK OWNER COPY (INITIAL): GOLD