IREDELL COUNTY HEALTH DEPARTMENT

STATESVILLE 704-878-5305 MOORESVILLE 704-664-5281

IMPROVEMENT PERMIT / AUTHORIZATION TO CONSTRUCT / OPERATION PERMIT / EXISTING SYSTEM INSPECTION

PERMIT# 090351 PIN# 4752167243 Shop#/Pg 565 9295 DATE 7/5/2000

OWNER OR CONTRACTOR Larry Tucker PHONE: Business 873-8763 Home 873-3948

ADDRESS 346 Shiloh Rd Statesville, NC 28677

LOCATION I-77 S. TL Amity Hill Rd TL Dover Rd (runs Next to I-77) approx. 1-1½ miles on left

SUBDIVISION — BLOCK / SECTION — LOT 5 LOT AREA 4.68 Acre SITE CLASS PS DESIGN FLOW 360gpd L.T.A.R. .3

Septic Tank: 1000 Gallons; STB 794 Date 8/24/00
Pump Tank: — Gallons; PT — Date —
Pump Make: — Model — Serial No. —
Nitrification Field: No Fields 1 Square Feet 1200' Linear Feet 400'
No Lines 5 at 80' Trench Width 36" Max Trench Bottom Depth 36"

[X] New System [ ] Repair System Type: I, II, III, IV, V, VI
System Description: Gravity - Conventional
Repair System Description: Same
Maintenance Agreement Required: [ ] Yes [X] No

[X] House/Mod. Home [ ] Mobile Home [ ] Business [ ] Other
No. Bedrooms 3 No. Bathrooms 2.5 No. Employees —


Water Supply: [X] Individual [ ] Public [ ] Community

Gravel Depth 12" [ ] Slab [X] Crawl Space [ ] Basement w/plumbing [ ] Basement wo/plumbing


Comments/Conditions: Keep Septic System at least 10' from PL, 5' from house & 100' from well. Feather off old farm berms & divert Storm/Surface water away from drainfield.

Comments/Conditions:

INITIAL SITE SKETCH Not to Scale

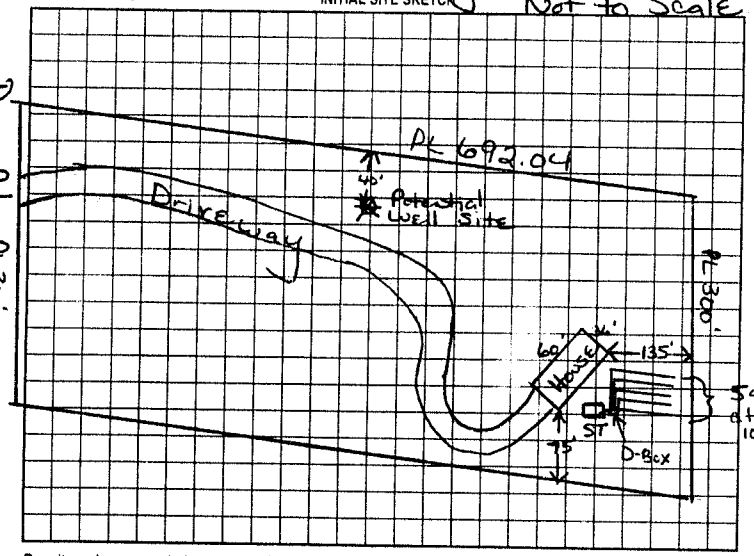

AS BUILT SKETCH

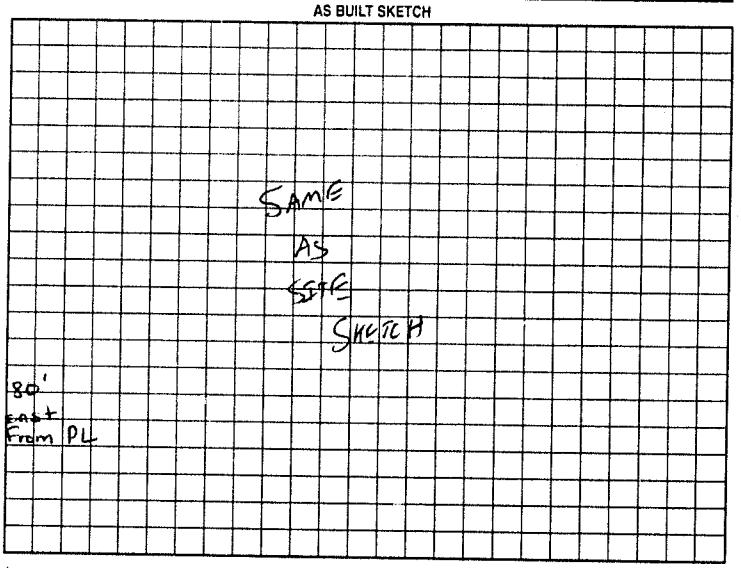

Permit can be suspended or revoked if any false information is supplied toward securing the permit/any unauthorized changes are made to the site/any unauthorized changes are made in the installation of the system. Improvement Permit with plat valid without expiration. Improvement Permit with site plan valid for sixty months. Authorization to Construct is valid for a period equal to that of Improvement Permit – not to exceed sixty months.

Signed: Larry Tucker date 7-5-00 Installed by: MARTY TUCKER

Improvement Permit by: Maria H. Dolan RS date 7/5/2000 Operation Permit by: C. Ty RS date 10/6/00

Authorization to Construct by: Maria H. Dolan RS date 7/5/2000 Existing System Inspection by: — date —

HEALTH DEPT. COPY: WHITE OWNER COPY (FINAL): YELLOW OWNER COPY (INITIAL): PINK