IREDELL COUNTY HEALTH DEPARTMENT

STATESVILLE 704-878-5305 MOORESVILLE 704-664-5281

IMPROVEMENT PERMIT / AUTHORIZATION TO CONSTRUCT / OPERATION PERMIT / EXISTING SYSTEM INSPECTION

PERMIT# 75840 PIN# DATE 8-31-98

OWNER OR CONTRACTOR Iredell Co Fraternal order of Police PHONE: Business 878 2506 Home

ADDRESS PO Box 5304 Statesville, N.C.

LOCATION I-77 TL Amity Hill TL Dover RD Inst TR Into Property

SUBDIVISION 1500 BLOCK / SECTION LOT LOT AREA 34.8 acres SITE CLASS. PS DESIGN FLOW 360 L.T.A.R. .4

Septic Tank: ~~1000~~ Gallons; STB 1011 Date 3-7-99
Pump Tank: Gallons; PT Date
Pump Make: Model Serial No.
Nitrification Field: No Fields 1 Square Feet 900 Linear Feet 300
No Lines 3 Trench Width 36" Max Trench Bottom Depth 36" Gravel Depth 12"

☑ New System ☐ Repair System Type: I, II, III, IV, V, VI
System Description: Conv. Gravity
Repair System Description: " "
Maintenance Agreement Required: ☐ Yes ☑ No
☑ Slab ☐ Crawl Space ☐ Basement w/plumbing ☐ Basement wo/plumbing


☐ House/Mod. Home No. Bedrooms
☐ Mobile Home No. Bathrooms
☐ Business No. Employees
☑ Other club House

Water Supply: ☑ Individual ☐ Public ☐ Community


Comments:/Conditions:
Total Lines 424'
Total 58' 1272'
With increase

Comments:/Conditions: Property line

INITIAL SITE SKETCH

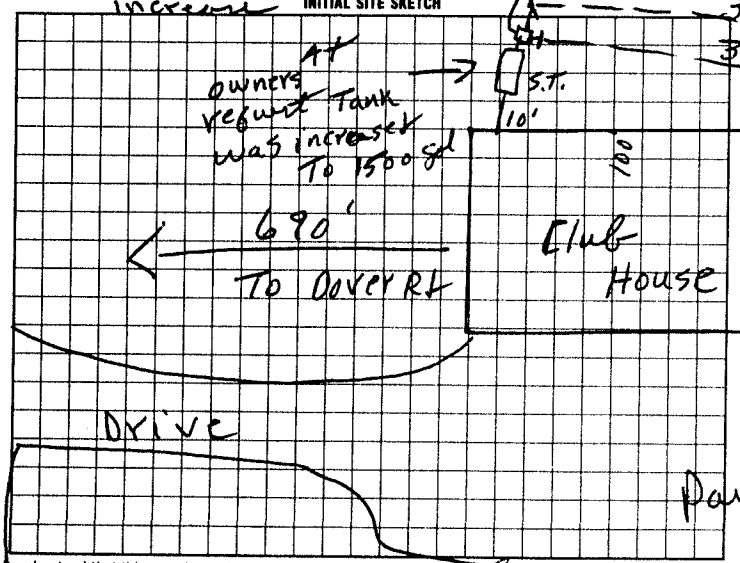

AS BUILT SKETCH

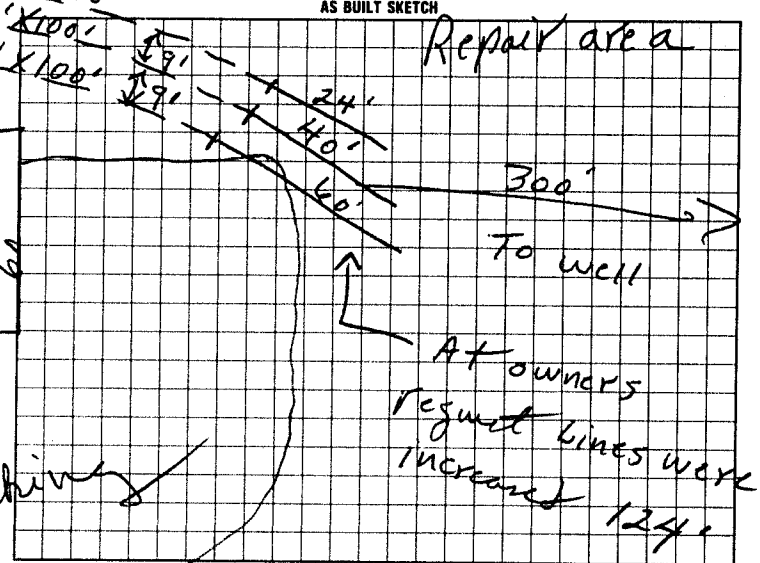

I understand that this permit can be suspended or revoked if any false information is supplied toward securing the permit/any unauthorized changes are made to the site/any unauthorized changes are made in the installation of the system. Improvement Permit with plat valid without expiration. Improvement Permit with site plan valid for sixty months. Authorization to Construct is valid for a period equal to that of Improvement Permit – not to exceed sixty months.

Signed: [signature] date Installed by: Esker Elliker

Improvement Permit by: L. C. Moore date 8-31-98 Operation Permit by: L. C. Moore date 7-12-99

Authorization to Construct by: L. C. Moore date 8-31-98 Existing System Inspection by: date

HEALTH DEPT. COPY: WHITE INSPECTION COPY (FINAL): GREEN OWNER COPY (FINAL): YELLOW INSPECTION COPY (INITIAL): PINK OWNER COPY (INITIAL): GOLD