IREDELL COUNTY HEALTH DEPARTMENT

Authorization to Construct

STATESVILLE 704-878-5305 MOORESVILLE 704-664-5281

IMPROVEMENT PERMIT / ~~CERTIFICATE OF COMPLETION~~ / OPERATION PERMIT / EXISTING SYSTEM INSPECTION

PROPERTY DESCRIPTION NO. 23088 DATE 2/20/96 TAX MAP NO. 5M-A-74 Watershed: ☐ Yes ☑ No

OWNER OR CONTRACTOR Mary Gwinnir PHONE: Business Home 873-1481

ADDRESS OH Twn Mobile Home 3016 North Side Dr, Statesville NC 28677

LOCATION I-40 E - I 77 S - Barium Spring Exit - Tk Amity Hill Rd. - Lt on Lt Before Tucker Rd

SUBDIVISION Amity Acres BLOCK / SECTION LOT 2 LOT AREA 238x85x64' SITE CLASS PS DESIGN FLOW 360gpd L.T.A.R. .3 gpd/ft²

Septic Tank: 1000 Gallons: STB 794 Date 10/31/95

Pump Tank: Gallons: PT Date

Pump Make: Model Serial No.

Nitrification Field No Fields 1 Square Feet 1200 Linear Feet 400

No Lines 5 Trench Width 36" Max Trench Bottom Depth 36" Gravel Depth 12"

☑ New System ☐ Repair System Type I ◉ III IV V VI

System Description: Gravity Conventional

Repair System Description: Panel

Maintenance Agreement Required Yes ☑ No

☐ Slab ☑ Crawl Space Basement w/plumbing Basement wo/plumbing

House/Mod Home No Bedrooms 3

☑ Mobile Home No Bathrooms 2

Business No Employees


Other

Water Supply ☑ Individual ☐ Community ☐ Public


Comments:

Comments Mobile Home or well not located at time of inspection.

INITIAL SITE SKETCH

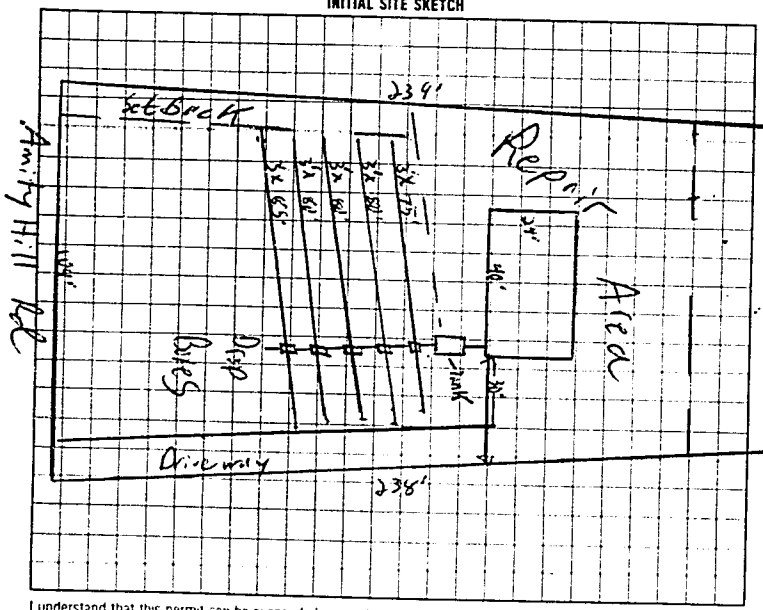

AS BUILT SKETCH

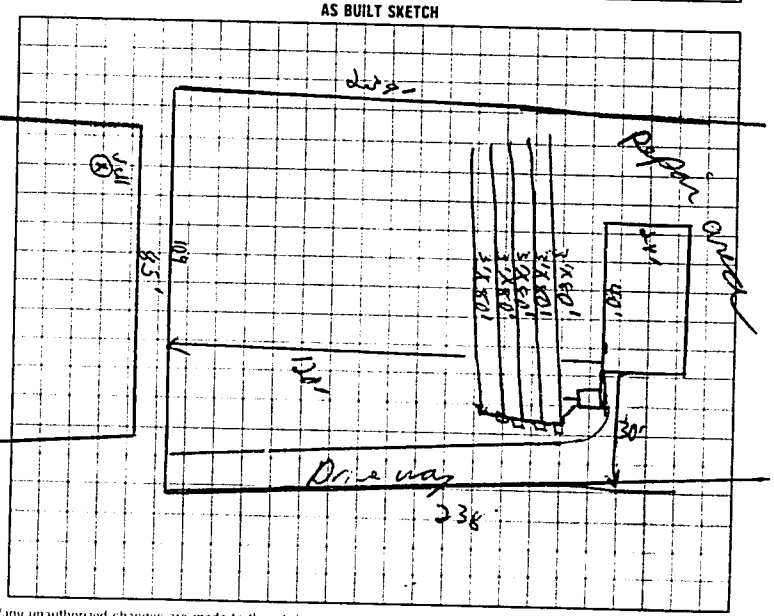

I understand that this permit can be suspended or revoked if any false information is supplied toward securing the permit/any unauthorized changes are made to the site/any unauthorized changes are made in the installation of the system

Authorization to Construct is valid for 5 yrs. Improvements permit does not expire.

Signed X William Michael Holland Jr.

Improvement Permit by C. Brad Frame date 2/20/96

~~Authorization to Construct~~ Existing System Inspection by C. Brad Frame date 2/26/96

Installed by

Certificate of Completion by C. Brad Frame EHSI date 2/26/96

Operation Permit by C. Brad Frame EHSI date 3/26/96

HEALTH DEPT COPY WHITE INSPECTION COPY (FINAL) GREEN OWNER COPY (FINAL) YELLOW INSPECTION COPY (INITIAL) PINK OWNER COPY (INITIAL)

OSTOOO