IREDELL COUNTY HEALTH DEPARTMENT - *ENVIRONMENTAL HEALTH* ☐ STATESVILLE OFFICE 704-878-5305 ☐ MOORESVILLE OFFICE 704-664-5281

IMPROVEMENT PERMIT / AUTHORIZATION TO CONSTRUCT / OPERATION PERMIT / EXISTING SYSTEM INSPECTION

PERMIT # 164919 PIN # 4752-30-3097 DATE JANUARY 27, 2011

OWNER RAY V. GWINNER APPLICANT: FREEDOM HOMES PHONE: Home/Cell # 704-528-7960 Business # 704-746-4778

SITE ADDRESS 3231 AMITY HILL ROAD OWNER / APPLICANT ADDRESS

SITE DIRECTIONS US 21 SOUTH, TL AMITY HILL ROAD, LOT ON LEFT JUST BEFORE TUCKER ROAD AT #3231

SUBDIVISION AMITY ACRES BLOCK / SECTION LOT # 2 LOT AREA 0.528 ACRE DESIGN FLOW 360 L.T.A.R. 0.30 GPD/FT2

Septic Tank 1000 Gallons: STB Date

Pump Tank Gallons: P T Date

Pump Make Model Serial #

No. Nitrification Fields: 1 No. Lines 5 Linear Feet 400

Trench Width 36" Max. Trench Bottom Depth Gravel Depth 12"

☐ New System ☐ Repair ☐ Expansion System Type I (II) III IV V VI

System Description: CONVENTIONAL GRAVITY

Repair System Description: PPBDS LOW-PRESSURE

Maintenance Agreement Required ☐ YES ☑ NO

☑ GRAVITY ☐ PRESSURE

☑ Residence No. Bedrooms 3

☐ Business No. Persons

☐ Other No. Employees

☐ Slab ☑ Crawl Space

☐ Basement w/plumbing ☐ Basement w/o plumbing

Water Supply: ☑ Private WELL ☐ Public ☐ Community


Comments / Conditions

KEEP FOUNDATION MINIMUM FIVE (5) FEET FROM SYSTEM.
NO VEHICULAR TRAFFIC ALLOWED OVER SYSTEM.

INITIAL SITE SKETCH

AS BUILT SKETCH

SCALE: 1" = 40'
(THIS IS NOT A SURVEY)

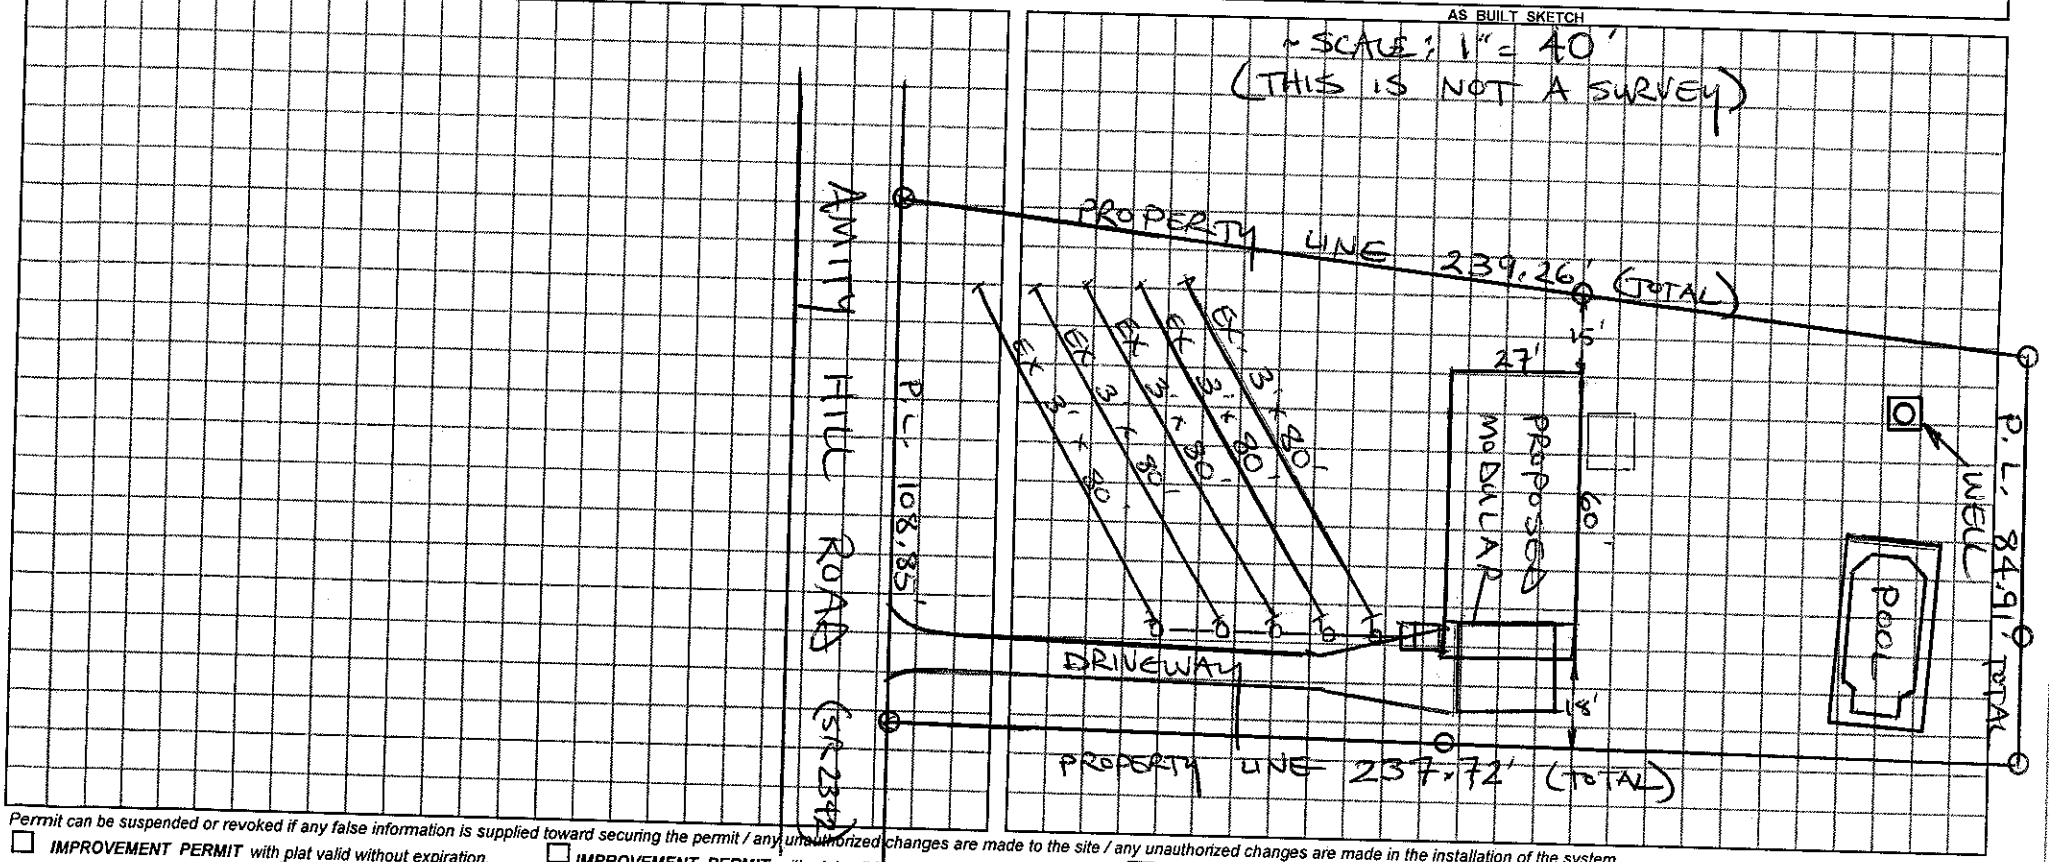

Permit can be suspended or revoked if any false information is supplied toward securing the permit / any unauthorized changes are made to the site / any unauthorized changes are made in the installation of the system.

☐ ***IMPROVEMENT PERMIT*** with plat valid without expiration. ☐ ***IMPROVEMENT PERMIT*** with plat valid without expiration. ☐ ***AUTHORIZATION TO CONSTRUCT*** valid for period equal to IMPROVEMENT PERMIT--not to exceed 60 mo.

Owner / Applicant Signature: Ray Wynn Date 1-28-11 Installed by:

IMPROVEMENT PERMIT by: REHS Date OPERATION PERMIT by: REHS Date

AUTHORIZATION TO CONSTRUCT by: REHS Date Existing System Inspected by: STEVE HEDRICK REHS Date 1-27-2011

YOU SHOULD CONTACT A LOCATOR SERVICE PRIOR TO ANY EXCAVATION

White Copy – Environmental Health YELLOW COPY (Final) Owner / Applicant PINK COPY (Initial) Owner / Applicant