ICHD - ENVIRONMENTAL HEALTH DIVISION

Statesville Office (704) 878-5305 Mooresville Office (704) 660-3625

MW ManF-2023-14680

PERMIT # AP2022-11047

PIN # 4752 -- 30 -- 6514

SEPTIC: IMPROVEMENT PERMIT / AUTHORIZATION TO CONSTRUCT / OPERATION PERMIT / EXISTING SYSTEM

APPLICANT/OWNER: Doug Curtis APPLICANT ADDRESS: 163 Tucker Rd, Statesville

SITE ADDRESS: 117 My Dr, Statesville 28625 PHONE: 704-500-6644 ALT. PHONE


SITE DIRECTIONS: 115S - Amity Hill - Tucker - My SAP CONTROLLED: ☐ YES ☐ NO

SUBDIVISION: My Home Park MHP SECTION: LOT # LOT AREA: 3 acres DESIGN FLOW: EX L.T.A.R.: EX

Septic Tank	EX (gal)	STB	Date	☐ New System	☐ Repair	☐ Expansion	System Type: I (II) III IV V VI	☒ Residence	No. Bedrooms	3	Water Supply		
Pump Tank	(gal)	PT	Date	System Description:	EXISTING			☐ Business	No. Persons	6	☐ Private		
Pump Make	Model		Serial #	Repair System Description:	-			☐ Other	No. Employees		☐ Public		
# Nitrification Fields	EX # Lines	EX	Linear Ft EX	Maintenance Agreement Required:	☐ YES	☒ NO		☐ Slab	☒ Crawl Space		☒ Community		
Trench Width	EX Trench Bottom Depth(Low side)	EX	Gravel Depth EX		☒ GRAVITY	☐ PRESSURE		☐ Basement w/plumbing			☐ Basement w/o plumbing		

Comments / Conditions: System appeared to be working at time of inspection.
No foundation drains to be installed around the house.

INITIAL SITE SKETCH

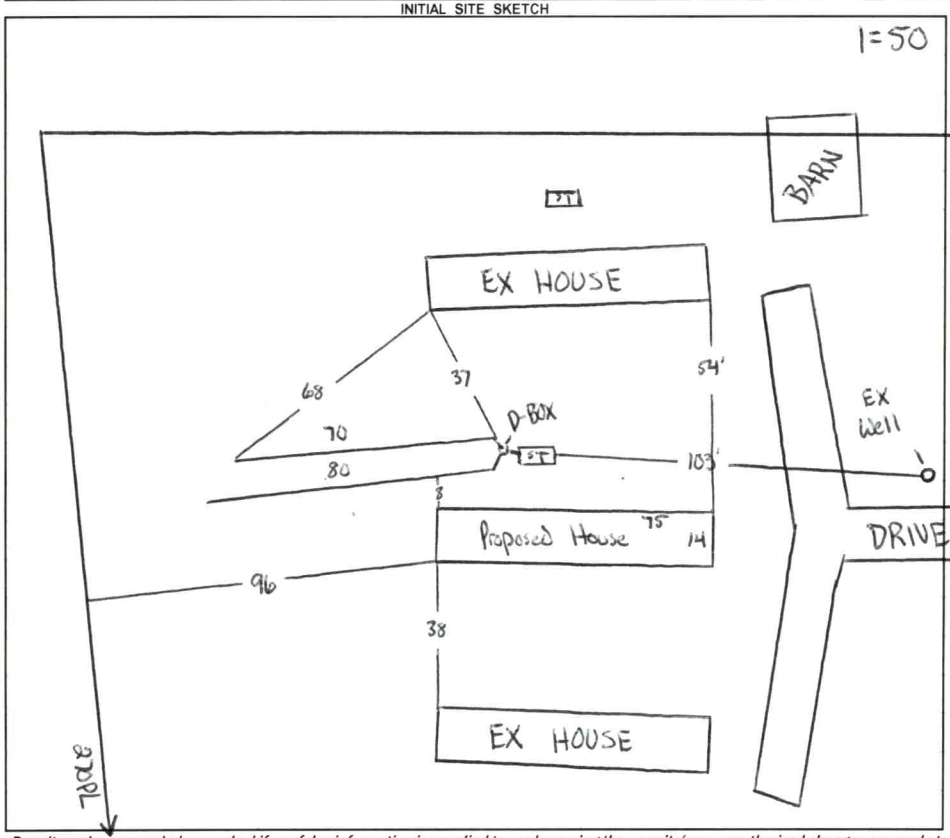

AS BUILT SKETCH

FOR SEPTIC FINAL INSPECTION CALL: 704-664-3703 between 8am-9am
the day the inspection is needed. Be sure to speak with an inspector to confirm your time.

Permit can be suspended or revoked if any false information is supplied toward securing the permit / any unauthorized changes are made to the site / any unauthorized changes are made in the installation of the system. **CONTACT A LOCATOR SERVICE PRIOR TO ANY EXCAVATION**

☐ **IMPROVEMENT PERMIT** ***with plat*** *valid without expiration.* ☐ **IMPROVEMENT PERMIT** ***with site plan*** *valid for 60 mos.* ☐ **AUTHORIZATION TO CONSTRUCT** *valid for period equal to IMPROVEMENT PERMIT--not to exceed 60 mo.*

Owner / Applicant Signature: Online Signature Date: Installed by:

IMPROVEMENT PERMIT by: Date: OPERATION PERMIT by: Date:


AUTHORIZATION TO CONSTRUCT by: Date: Existing System Inspected by: Cory Hil Date: 1/18/23

FOR SEPTIC FINAL INSPECTION: CALL 704-664-3703 between 8am-9am the day the inspection is needed.

Item	Date	Initials
Drain Lines Checked		
Tanks Checked		
Pressure Manifold or Valve Box Checked		
Pressure Head Set		
Electrical Checked		
Floats Set		
Alarm Checked		
Maintenance Contract Needed? Y / N		
Comments:		

Repairs Only	
	State Code
Failing System Code	
Type of Distribution	G or P
Type of Failure/Malfunction	
Primary Cause of Failure/Malfunction	
Age of System? _____	
Initial or Repair? _____	

117 My Drive

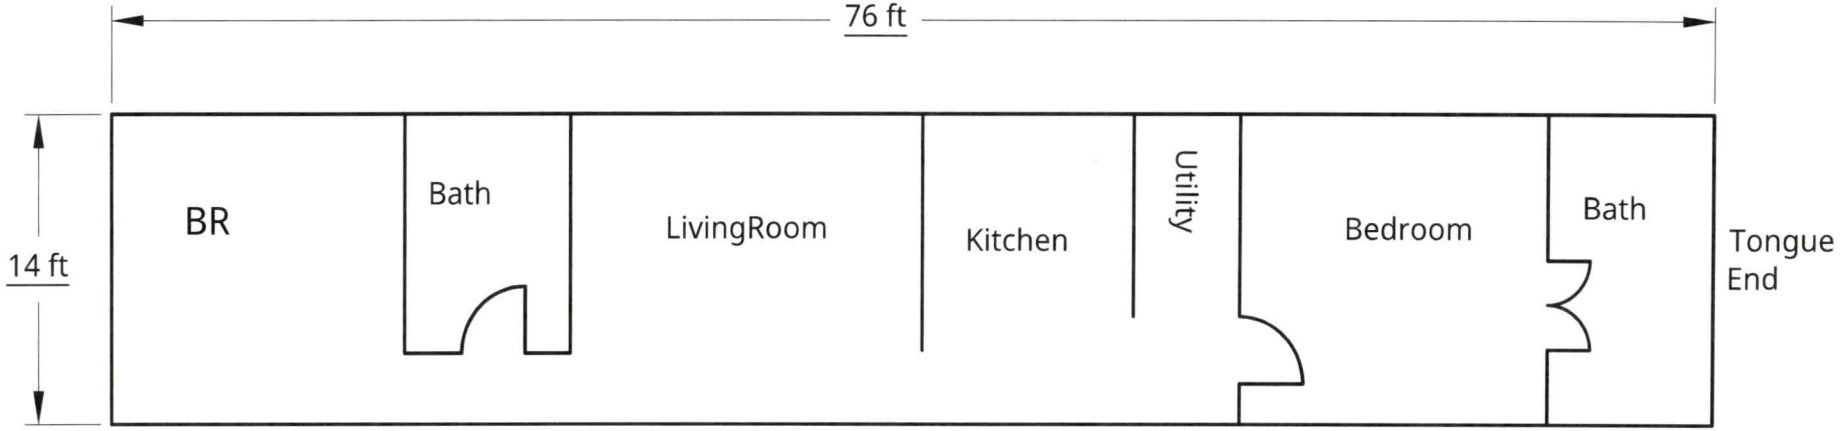

Front of home

1/20/23