IREDELL COUNTY HEALTH DEPARTMENT

STATESVILLE 704-878-5305 MOORESVILLE 704-664-5281

IMPROVEMENT PERMIT / AUTHORIZATION TO CONSTRUCT / OPERATION PERMIT / EXISTING SYSTEM INSPECTION

PERMIT# 73992 PIN# 4752327489 DATE 6-16-98

OWNER OR CONTRACTOR William B Thomas PHONE: Business Home 872 2215

ADDRESS 505 W Russell St. Statesville, N.C.

LOCATION I-77 S Exit 46 TL Amity Hill TL Tucker Rd TL Hurst Dr. 1st mh Rt

SUBDIVISION BLOCK / SECTION LOT LOT AREA 1.15 acres SITE CLASS. PS DESIGN FLOW 240 L.T.A.R. .33

Septic Tank: 1000 Gallons; STB 1017 Date 4-25-98
Pump Tank: Gallons; PT Date
Pump Make: Model Serial No.
Nitrification Field: No Fields 1 Square Feet 720 Linear Feet 240
No Lines 3 Trench Width 36" Max Trench Bottom Depth 36" Gravel Depth 12"


☑ New System ☐ Repair System Type: I, II, III, IV, V, VI
System Description: Conv. Gravity
Repair System Description: Pump To Chambers
Maintenance Agreement Required: ☐ Yes ☑ No

☐ House/Mod. Home No. Bedrooms 2
☑ Mobile Home No. Bathrooms 2
☐ Business No. Employees
☐ Other
☐ Slab ☑ Crawl Space ☐ Basement w/plumbing ☐ Basement wo/plumbing

Water Supply: ☑ Individual ☐ Public ☐ Community


Comments:/Conditions:

INITIAL SITE SKETCH

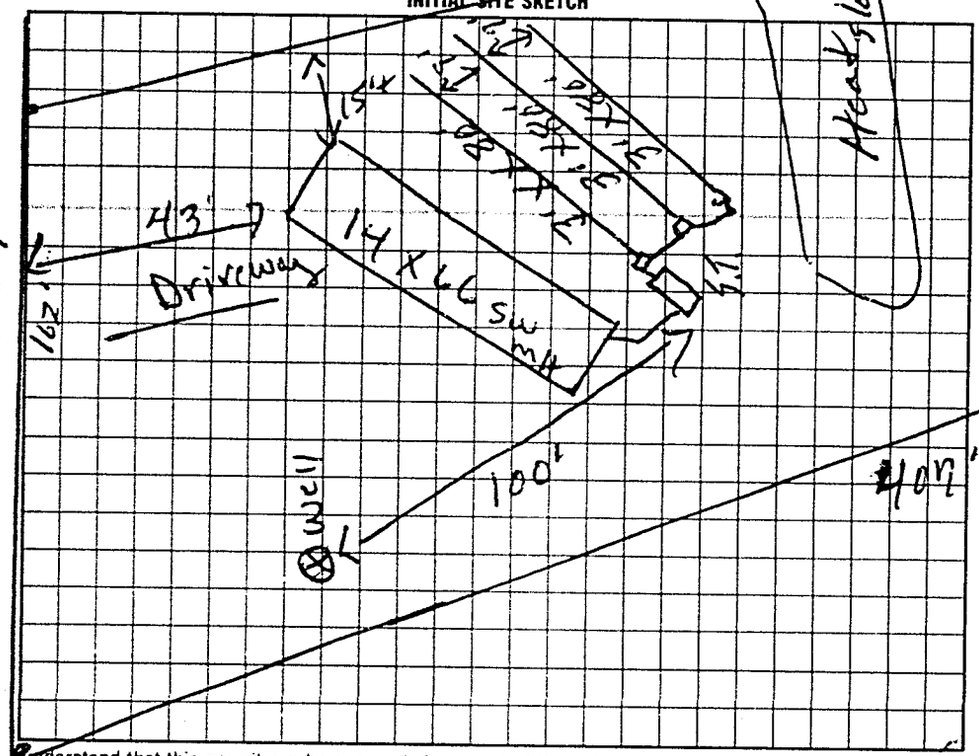

Comments:/Conditions:

AS BUILT SKETCH

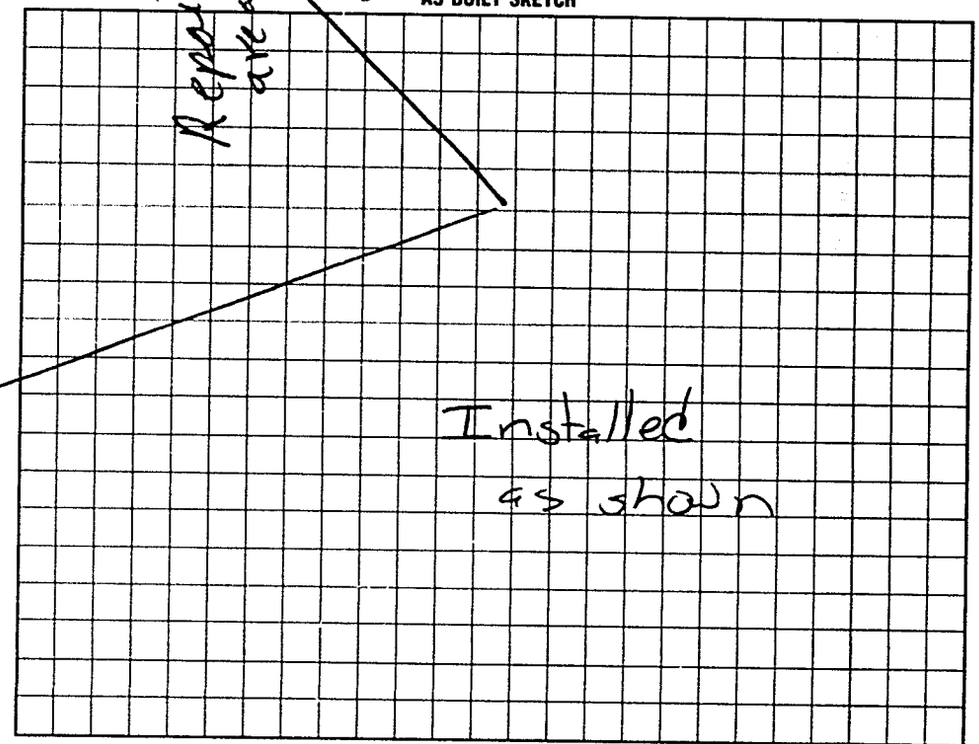

I understand that this permit can be suspended or revoked if any false information is supplied toward securing the permit/any unauthorized changes are made to the site/any unauthorized changes are made in the installation of the system. Improvement Permit with plat valid without expiration. Improvement Permit with site plan valid for sixty months. Authorization to Construct is valid for a period equal to that of Improvement Permit – not to exceed sixty months.

Signed: X Joey Stevens date

Improvement Permit by: F.C. Moore date 6-16-98

Authorization to Construct by: F.C. Moore date 6-16-98

Installed by: Rick Shook

Operation Permit by: Mark Collins RS date 7-1-98

Existing System Inspection by date

HEALTH DEPT COPY: WHITE INSPECTION COPY (FINAL): GREEN OWNER COPY (FINAL): YELLOW INSPECTION COPY (INITIAL): PINK OWNER COPY (INITIAL): GOLD