IREDELL COUNTY HEALTH DEPARTMENT

STATESVILLE 704-878-5305 MOORESVILLE 704-664-5281

IMPROVEMENT PERMIT / AUTHORIZATION TO CONSTRUCT / OPERATION PERMIT / EXISTING SYSTEM INSPECTION

PERMIT# 124520 PIN# 4752-33-2367 DATE 11-1-04

OWNER OR CONTRACTOR RANDALL HOOKS PHONE: Business 704-902-4526 Home

ADDRESS 183 HURST DRIVE, STATESVILLE, NC 28677

LOCATION 4521 S, TL AMITY HILL ROAD, TL TUCKER RD, TL HURST DRIVE, HOUSE AT END AT #183

SUBDIVISION BLOCK / SECTION LOT LOT AREA 3.95 ACRES SITE CLASS. PS DESIGN FLOW 360 L.T.A.R. 0.40 GPD/FT2

Septic Tank: EXISTING Gallons; STB Date

Pump Tank: Gallons; PT Date

Pump Make: Model Serial No.

Nitrification Field: No Fields 1 Square Feet 300 Linear Feet 100

No Lines ONE Trench Width 36" Max Trench Bottom Depth 36" Gravel Depth 12"

☑ New System ☐ Repair System Type: I, II, III, IV, V, VI

System Description: CONVENTIONAL GRAVITY

Repair System Description: 25% REDUCTION, PUMP

Maintenance Agreement Required: ☐ Yes ☑ No

☑ House/Mod. Home No. Bedrooms 3

☐ Mobile Home No. Bathrooms

☐ Business No. Employees

☐ Other


☐ Slab ☑ Crawl Space ☐ Basement w/plumbing ☐ Basement wo/plumbing

Water Supply:
☑ Individual
☐ Public
☐ Community
WELL

Comments:/Conditions:
1) INTERSECT EXISTING DRAIN LINE AT LOCATION SHOWN WITH NEW 3' x 100' CONVENTIONAL DRAINLINE ON CONTOUR (2) KEEP MODULAR HOME FOUNDATION MINIMUM 5' FROM SYSTEM

Comments:/Conditions:

INITIAL SITE SKETCH

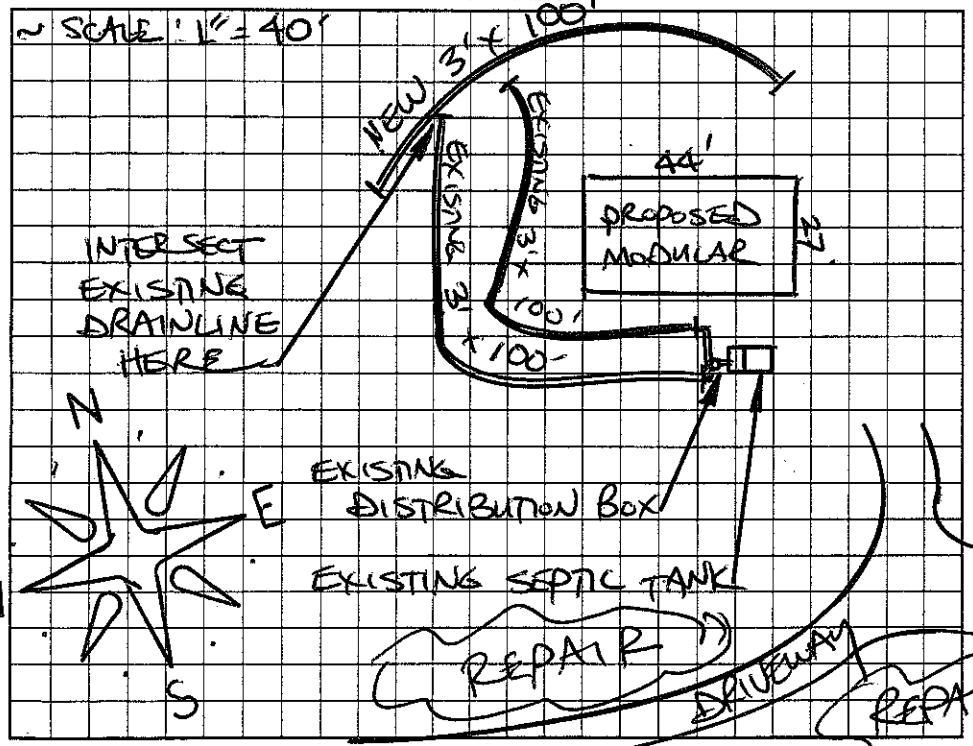

AS BUILT SKETCH

SYSTEM EXPANDED ACCORDING TO INITIAL SITE SKETCH

Permit can be suspended or revoked if any false information is supplied toward securing the permit/any unauthorized changes are made to the site/any unauthorized changes are made in the installation of the system. Improvement Permit with plat valid without expiration. Improvement Permit with site plan valid for sixty months. Authorization to Construct is valid for a period equal to that of Improvement Permit – not to exceed sixty months.

Signed: [signature] date 11-1-04

Improvement Permit by: STEVE HEDRICK date 11-1-04

Authorization to Construct by: STEVE HEDRICK date 11-1-04

Installed by: JAMES LENTZ

Operation Permit by: STEVE HEDRICK date 12-30-04

Existing System Inspection by: date

HEALTH DEPT. COPY: WHITE OWNER COPY (FINAL): YELLOW OWNER COPY (INITIAL): PINK