**IREDELL COUNTY HEALTH DEPARTMENT - *ENVIRONMENTAL HEALTH*** ☒ STATESVILLE OFFICE 704-878-5305 ☐ MOORESVILLE OFFICE 704-664-5281

**IMPROVEMENT PERMIT / AUTHORIZATION TO CONSTRUCT / OPERATION PERMIT / EXISTING SYSTEM INSPECTION**

PERMIT # Repair PIN # 4752-40-2508 DATE 11-3-10

OWNER Robert J. Wilhelm APPLICANT: PHONE: Home/Cell # 704-872-6415 Business #

SITE ADDRESS 134 Tucker Rd. OWNER / APPLICANT ADDRESS

SITE DIRECTIONS I-77 S, exit on #45, turn (L), (L) on Tucker Road, 1st house on right

SUBDIVISION none BLOCK / SECTION none LOT # — LOT AREA - DESIGN FLOW 360 L.T.A.R. .3

Septic Tank @1000 Gallons: STB Date

Pump Tank Gallons: P T Date

Pump Make Model Serial #

No. Nitrification Fields: 1 No. Lines 4 Linear Feet 300'

Trench Width 36" Max. Trench Bottom Depth 36" Gravel Depth n/a

☐ New System ☒ Repair ☐ Expansion System Type I II (III) IV V VI

System Description:

Repair System Description: 25% Reduction Gravity

Maintenance Agreement Required ☐ YES ☒ NO

☒ GRAVITY ☐ PRESSURE

☒ Residence No. Bedrooms 3

☐ Business No. Persons

☐ Other No. Employees

☐ Slab ☒ Crawl Space


☐ Basement w/plumbing ☐ Basement w/o plumbing

Water Supply: ☒ Private ☐ Public ☐ Community


Comments / Conditions If septic tank needs replacing, it may be replaced.

endcap distribution replaced

INITIAL SITE SKETCH

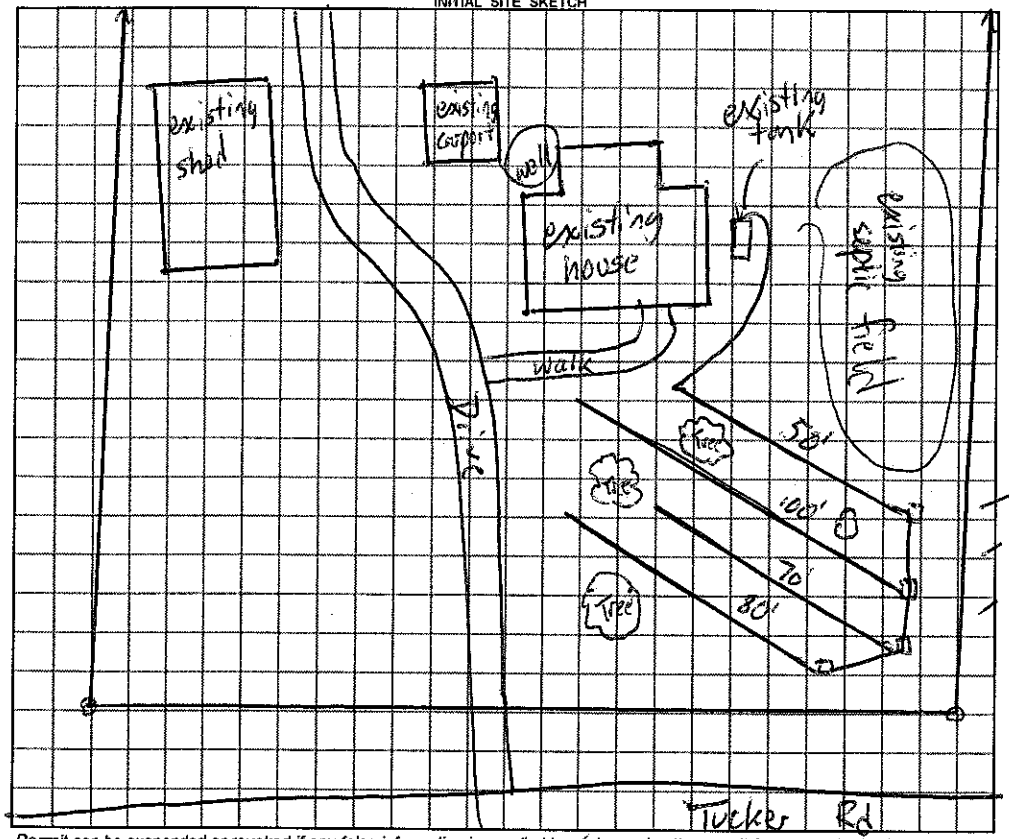


AS BUILT SKETCH

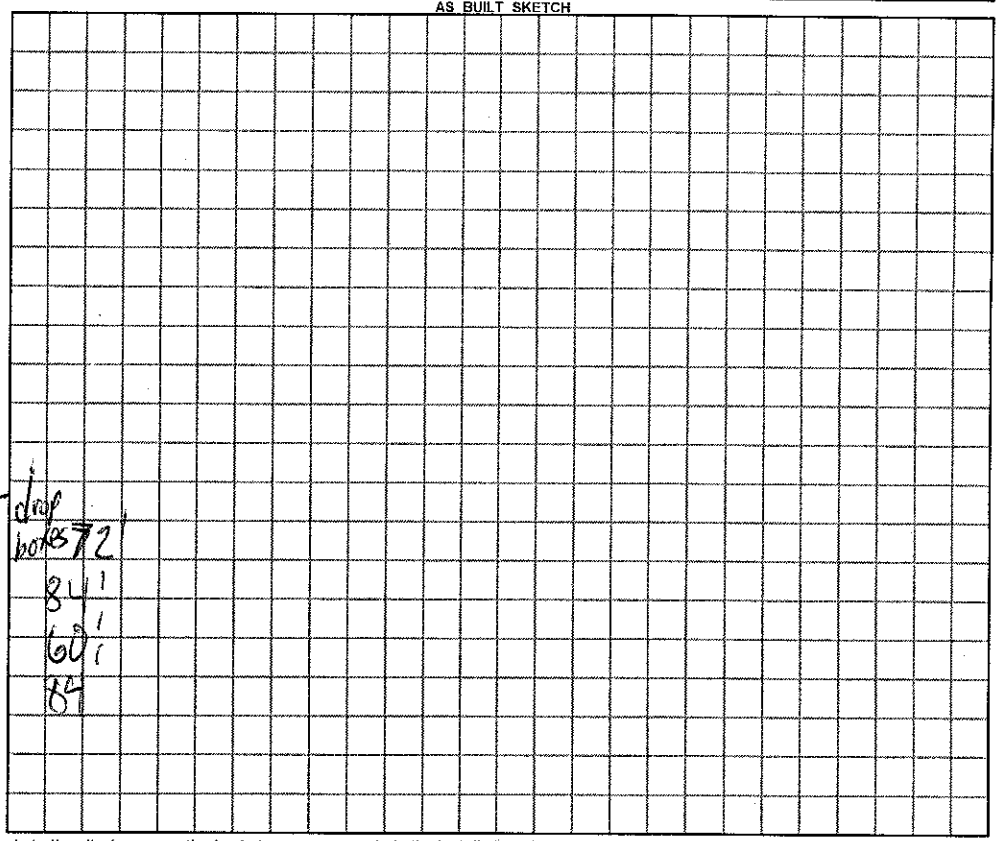


*Permit can be suspended or revoked if any false information is supplied toward securing the permit / any unauthorized changes are made to the site / any unauthorized changes are made in the installation of the system.*

☐ ***IMPROVEMENT PERMIT*** *with plat valid without expiration.* ☒ ***IMPROVEMENT PERMIT*** *with plat valid without expiration.* ☒ ***AUTHORIZATION TO CONSTRUCT*** valid for period equal to IMPROVEMENT PERMIT--not to exceed 60 mo.

Owner / Applicant Signature: Ethel Wilhelm Date 11-05-10 Installed by: A-1 Backhoe

IMPROVEMENT PERMIT by: REHS Date 11-3-10 OPERATION PERMIT by: REHS Date 11-9-10

AUTHORIZATION TO CONSTRUCT by: REHS Date 11-3-10 Existing System Inspected by: REHS Date

***YOU SHOULD CONTACT A LOCATOR SERVICE PRIOR TO ANY EXCAVATION***

White Copy – Environmental Health YELLOW COPY (Final) Owner / Applicant PINK COPY (Initial) Owner / Applicant