IREDELL COUNTY HEALTH DEPARTMENT

STATESVILLE 704-878-5305 MOORESVILLE 704-664-5281

IMPROVEMENT PERMIT / AUTHORIZATION TO CONSTRUCT / OPERATION PERMIT / EXISTING SYSTEM INSPECTION

PERMIT# 033377 PIN# 4752423586 DATE 8-17-99

OWNER OR CONTRACTOR Robert C Jones PHONE: Business _____ Home _____

ADDRESS PO Box 104 Barium Springs

LOCATION 77s TL Amity #11 TL Tucker on (R)

SUBDIVISION _____ BLOCK / SECTION _____ LOT _____ LOT AREA 320 acres SITE CLASS. _____ DESIGN FLOW 360 L.T.A.R. _____

Septic Tank: ~~1000~~ Ex Gallons; STB _____ Date _____

Pump Tank: 1250 Ex Gallons; PT _____ Date _____

Pump Make: _____ Model _____ Serial No. _____

Nitrification Field: No Fields ____ Square Feet _____ Linear Feet 300

No Lines 3 Trench Width _____ Max Trench Bottom Depth _____ Gravel Depth _____

☐ New System ☐ Repair System Type: I, II, III, IV, V, VI

System Description: _____

Repair System Description: _____

Maintenance Agreement Required: ☐ Yes ☐ No

☐ Slab ☒ Crawl Space ☐ Basement w/plumbing ☐ Basement wo/plumbing

☐ House/Mod. Home No. Bedrooms 3

☒ Mobile Home No. Bathrooms 2

☐ Business No. Employees ____

☐ Other _____


Water Supply: ☒ Individual ☐ Public ☐ Community

Comments/Conditions:


Comments/Conditions:

Existing System Check
Keep Footers 0 5ft from system

INITIAL SITE SKETCH

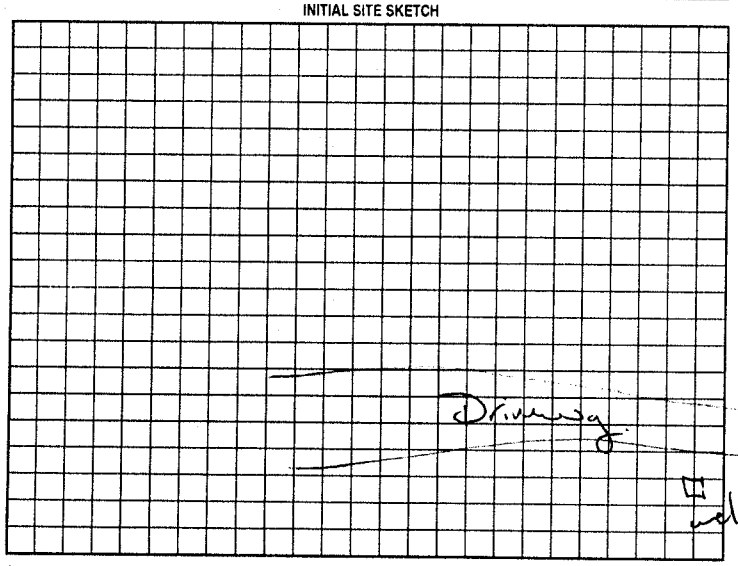

AS BUILT SKETCH

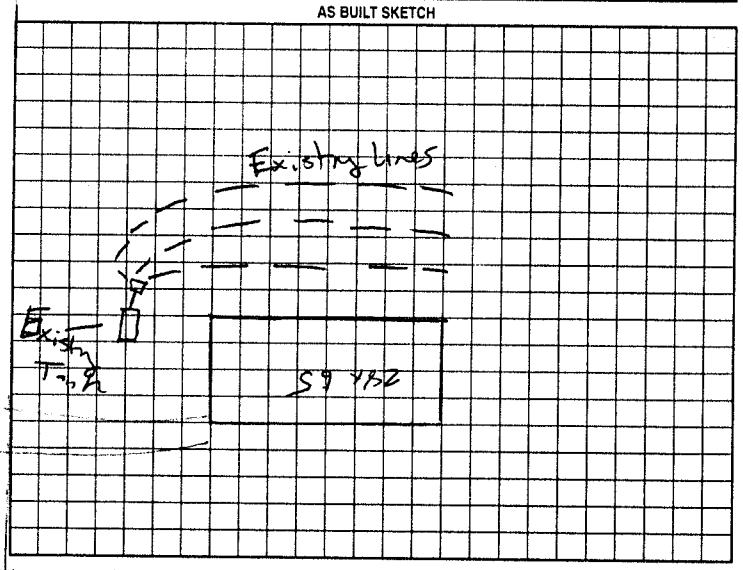

Permit can be suspended or revoked if any false information is supplied toward securing the permit/any unauthorized changes are made to the site/any unauthorized changes are made in the installation of the system. Improvement Permit with plat valid without expiration. Improvement Permit with site plan valid for sixty months. Authorization to Construct is valid for a period equal to that of Improvement Permit – not to exceed sixty months.

Signed: _____ date _____

Improvement Permit by: _____ date _____

Authorization to Construct by: _____ date _____

Installed by: _____

Operation Permit by: _____ date _____

Existing System Inspection by: C "of C Out" JS date 8-17-99

HEALTH DEPT COPY: WHITE OWNER COPY (FINAL): YELLOW OWNER COPY (INITIAL): PINK