IREDELL COUNTY HEALTH DEPARTMENT

STATESVILLE 704-878-5305 MOORESVILLE 704-664-5281

IMPROVEMENT PERMIT / AUTHORIZATION TO CONSTRUCT / OPERATION PERMIT / EXISTING SYSTEM INSPECTION

PERMIT# 20976 PIN# 4752424942 DATE 5-7-99

OWNER OR CONTRACTOR Norman Harless PHONE: Business Home 954 925 0689

ADDRESS 641 Northest 2nd Pl Denia, FL

LOCATION Amity Hill Rd Turn Tuckaway at end on rt.

SUBDIVISION BLOCK / SECTION LOT LOT AREA 1.98 acres SITE CLASS PS DESIGN FLOW 360 L.T.A.R. .3

Septic Tank: 1000 Gallons; STB 1012 Date 11-27-99
Pump Tank: Gallons; PT Date
Pump Make: Model Serial No.
Nitrification Field: No Fields 1 Square Feet 420 Linear Feet 210
No Lines 3 Trench Width 24" Max Trench Bottom Depth 36" Gravel Depth N/A

☑ New System ☐ Repair System Type: I. II III IV. V. VI
System Description: Gravity Panels
Repair System Description:
Maintenance Agreement Required: Yes ~~No~~


☐ House/Mod. Home No. Bedrooms 3
☑ Mobile Home No. Bathrooms 2
☐ Business No. Employees
☐ Other
Slab ~~Crawl Space~~ Basement w/plumbing Basement wo/plumbing

Water Supply: ☑ Individual ☐ Public ☐ Community


Comments/Conditions: 360 L

Comments/Conditions

INITIAL SITE SKETCH

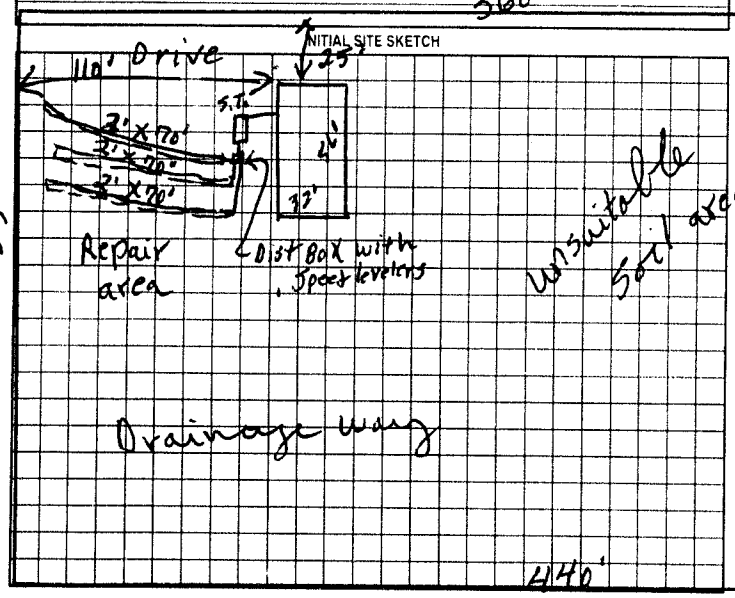

AS BUILT SKETCH

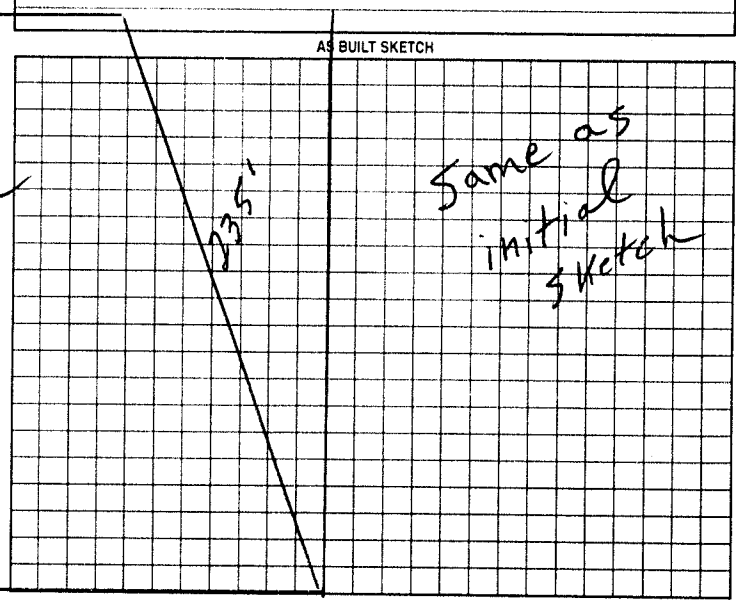

Permit can be suspended or revoked if any false information is supplied toward securing the permit/any unauthorized changes are made to the site/any unauthorized changes are made in the installation of the system. Improvement Permit with plat valid without expiration. Improvement Permit with site plan valid for sixty months. Authorization to Construct is valid for a period equal to that of Improvement Permit – not to exceed sixty months.

Signed: Norman H Harless date 8-9-99 Installed by: Tommy Frye

Improvement Permit by: P.C. moore date 5-7-99 Operation Permit by: P.C. moore date 10-6-99

Authorization to Construct by: P.C. moore date 5-7-99 Existing System Inspection by: date

HEALTH DEPT COPY WHITE OWNER COPY (FINAL) YELLOW OWNER COPY (INITIAL) PINK