ICHD - ENVIRONMENTAL HEALTH DIVISION

Statesville Office (704) 878-5305 Mooresville Office (704) 660-3625 PERMIT # 2023-27848

BLDR - 2023-27843

SEPTIC: IMPROVEMENT PERMIT / AUTHORIZATION TO CONSTRUCT / OPERATION PERMIT / EXISTING SYSTEM

PIN # 4752 -- 43 -- 3105

APPLICANT/OWNER: Larry & Mynday APPLICANT ADDRESS: 673 Shiloh Rd, Statesville, NC 28677

SITE ADDRESS: 263 Tucker Rd, Statesville, NC 28677 PHONE: (704)902-1479 ALT. PHONE (704)902-1479


SITE DIRECTIONS: N Center St, ⓛ Amity Hill, ⓛ Tucker Rd SAP CONTROLLED: ☐ YES ☐ NO

SUBDIVISION: - SECTION: - LOT # - LOT AREA: .449 DESIGN FLOW: Ext L.T.A.R.: Ext

Septic Tank Ext	(gal)	STB	Date	☐ New System ☐ Repair ☐ Expansion	System Type: I (II) III IV V VI	☑ Residence	No. Bedrooms	2	Water Supply
Pump Tank	(gal)	PT	Date	System Description: Existing System		☐ Business	No. Persons	4	☐ Private
Pump Make	Model		Serial #	Repair System Description:		☐ Other	No. Employees		☐ Public
# Nitrification Fields Ext	# Lines Ext		Linear Ft Ext	Maintenance Agreement Required:	☐ YES ☑ NO	☐ Slab	☐ Crawl Space		☑ Community
Trench Width Ext	Trench Bottom Depth(Low side) Ext		Gravel Depth Ext	☑ GRAVITY	☐ PRESSURE	☐ Basement w/plumbing			☑ Basement w/o plumbing

Comments / Conditions: Existing System appears to be functioning upon inspection.

INITIAL SITE SKETCH

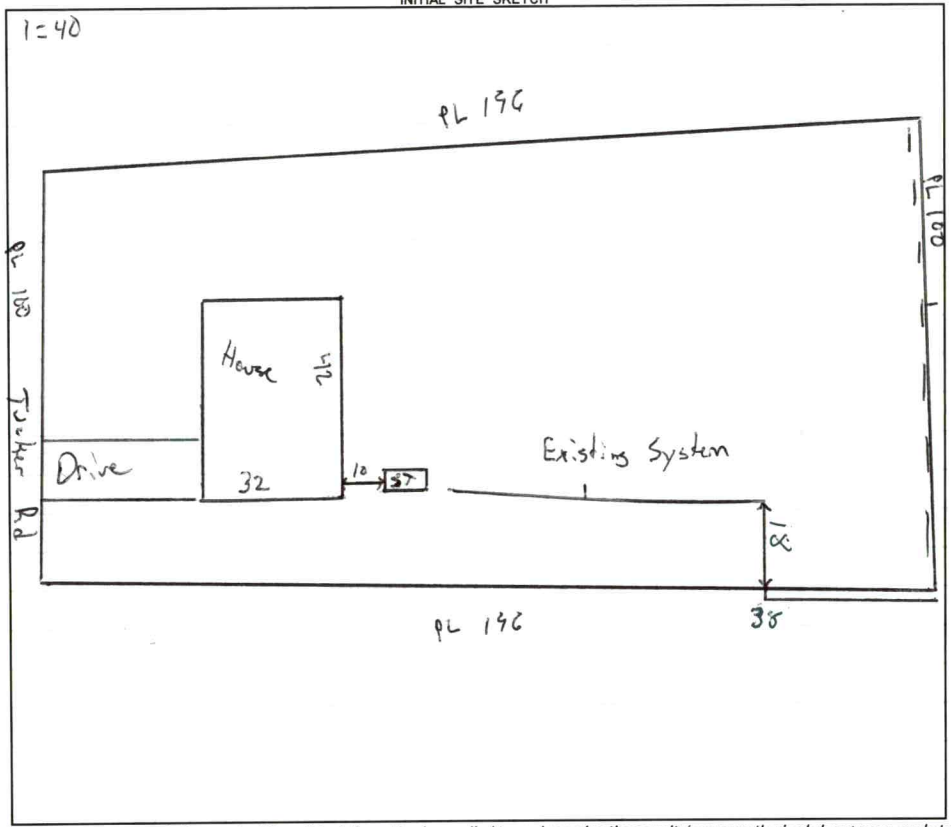

AS BUILT SKETCH

FOR SEPTIC FINAL INSPECTION CALL: 704-664-3703 between 8am-9am
the day the inspection is needed. Be sure to speak with an inspector to confirm your time.

Permit can be suspended or revoked if any false information is supplied toward securing the permit / any unauthorized changes are made to the site / any unauthorized changes are made in the installation of the system. **CONTACT A LOCATOR SERVICE PRIOR TO ANY EXCAVATION**

☐ **IMPROVEMENT PERMIT** ***with plat*** *valid without expiration.* ☐ **IMPROVEMENT PERMIT** ***with site plan*** *valid for 60 mos.* ☐ **AUTHORIZATION TO CONSTRUCT** *valid for period equal to IMPROVEMENT PERMIT--not to exceed 60 mo.*

Owner / Applicant Signature: Online Signature Date: Installed by:


IMPROVEMENT PERMIT by: Date: OPERATION PERMIT by: Date:


AUTHORIZATION TO CONSTRUCT by: Date: Existing System Inspected by: Matt Wilkins Date: 6/29/22

FOR SEPTIC FINAL INSPECTION: CALL 704-664-3703 between 8am-9am the day the inspection is needed.

Item	Date	Initials
Drain Lines Checked		
Tanks Checked		
Pressure Manifold or Valve Box Checked		
Pressure Head Set		
Electrical Checked		
Floats Set		
Alarm Checked		
Maintenance Contract Needed? Y / N		
Comments:		

Repairs Only	
	State Code
Failing System Code	
Type of Distribution	G or P
Type of Failure/Malfunction	
Primary Cause of Failure/Malfunction	
Age of System? _____	
Initial or Repair? _____	

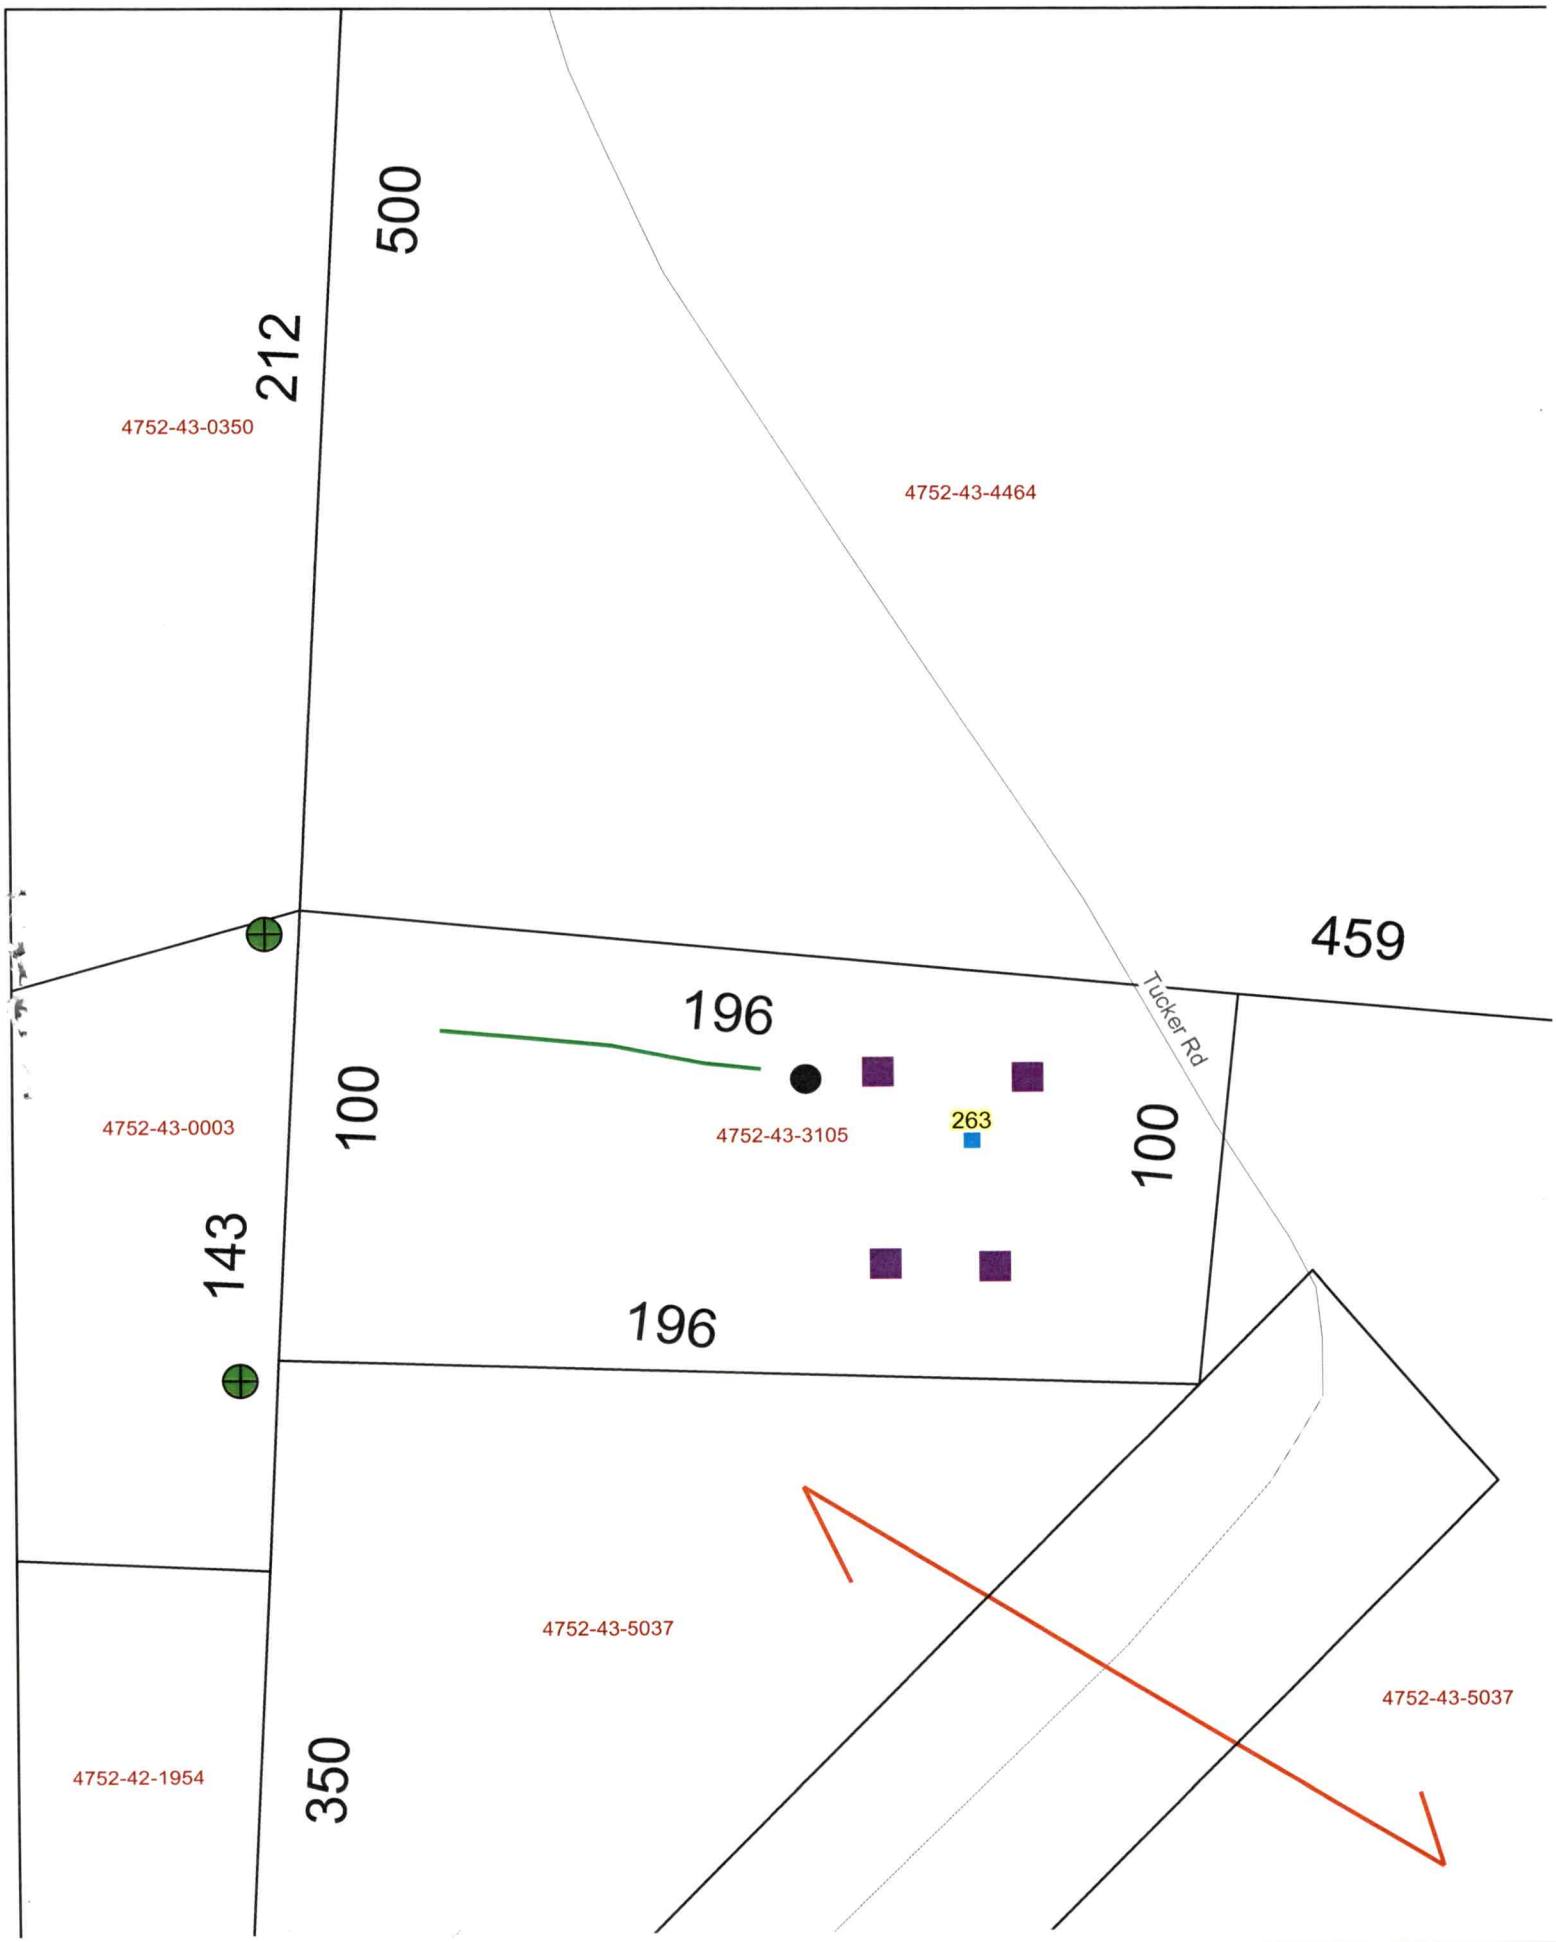
500
212
4752-43-0350
4752-43-4464
459
Tucker Rd
196
100
4752-43-0003
4752-43-3105
263
100
143
196
4752-43-5037
4752-43-5037
4752-42-1954
350

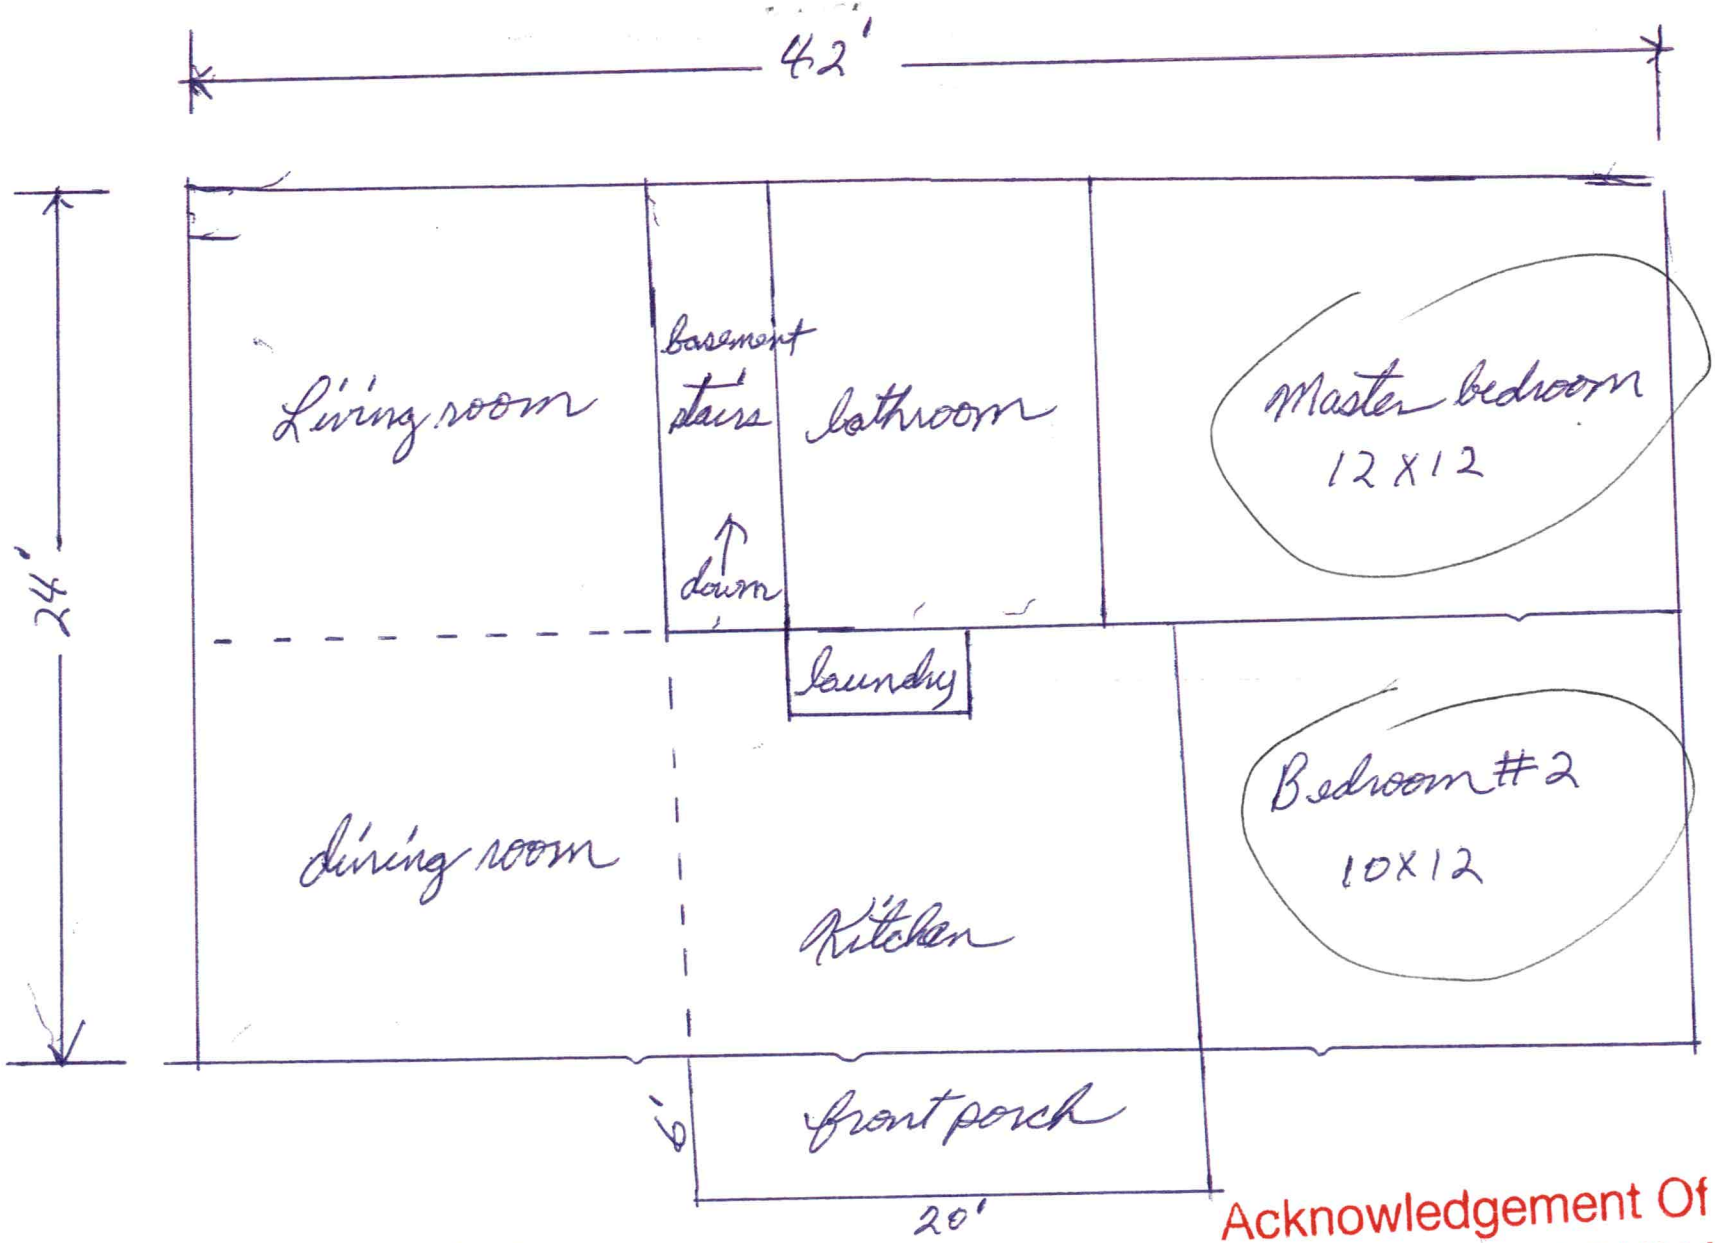

Mrs. Christine Rogers
263 Tucker Road
heated sq. ft. 1,008

Acknowledgement Of
Plans Submittal ONLY!

Date 7/6/23

Date