IREDELL COUNTY HEALTH DEPARTMENT

STATESVILLE 704-878-5305 (C1) MOORESVILLE 704-664-5281

IMPROVEMENT PERMIT / AUTHORIZATION TO CONSTRUCT / OPERATION PERMIT / EXISTING SYSTEM INSPECTION

PERMIT# 108853 PIN# 4752-44-9508.124 DATE 9-19-02

OWNER OR CONTRACTOR ROGER PLYLER PHONE: Business Home 704-871-1513

ADDRESS 124 PLYLER FARM LANE, STATESVILLE NC 28677

LOCATION US 70 EAST, TR SHILOH CHURCH RD, 2.1 MILES TR PLYLER FARM ROAD, MH AT END

SUBDIVISION BLOCK / SECTION LOT LOT AREA 86.12 ACRES SITE CLASS PS DESIGN FLOW 360 L.T.A.R. 0.33 GPD/FT²

Septic Tank EXISTING Gallons: STB Date

Pump Tank: Gallons: PT Date

Pump Make: Model Serial No.

Nitrification Field: No. Fields 1 Square Feet 450 Linear Feet 150'

No. Lines TWO Trench Width 36" Max Trench Bottom Depth 36"

☑ New System ☐ Repair System Type: I (II) III IV V VI

System Description: CONVENTIONAL GRAVITY

Repair System Description: CONVENTIONAL GRAVITY

Maintenance Agreement Required: ☐ Yes ☑ No

Gravel Depth 12"

☐ House/Mod. Home ☐ Mobile Home ☐ Business ☐ Other

No. Bedrooms

No. Bathrooms 2

No. Employees


☐ Slab ☑ Crawl Space ☐ Basement w/plumbing ☐ Basement wo/plumbing

Water Supply: ☑ Individual ☐ Public ☐ Community WELL

Comments/Conditions: ① EXPAND SYSTEM BY ADDING NEW DISTRIBUTION BOX FEEDING TWO NEW LINES AS SHOWN ② EXISTING S/W MH TO BE REMOVED UPON OCCUPANCY OF D/W MH. W

Comments/Conditions

INITIAL SITE SKETCH

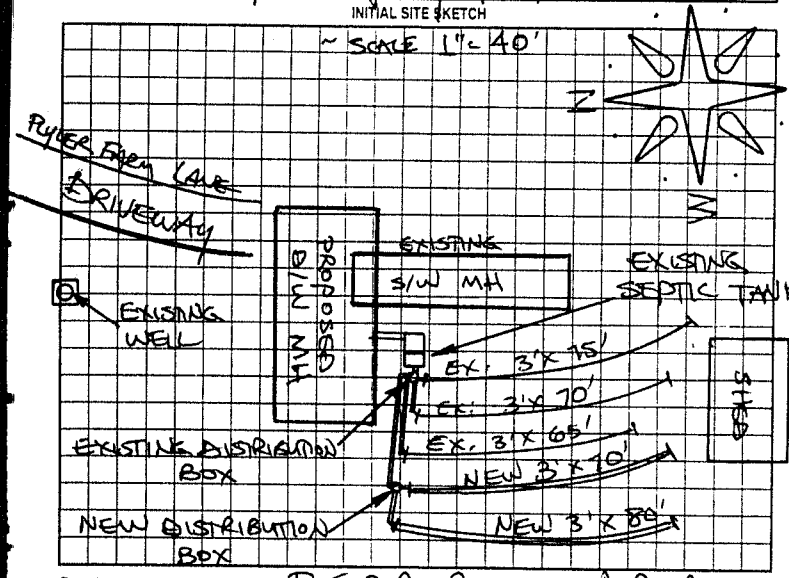

AS BUILT SKETCH

SYSTEM EXPANDED ACCORDING TO INITIAL SITE SKETCH

Permit can be suspended or revoked if any false information is supplied toward securing the permit, any unauthorized changes are made to the site any unauthorized changes are made in the installation of the system. Improvement Permit with plat valid without expiration. Improvement Permit with site plan valid for sixty months. Authorization to Construct is valid for a period equal to that of Improvement Permit – not to exceed sixty months

Signed: Malesia Plyler date 9-19-02

Improvement Permit by: STEVE HEDRICK date 9-19-02

Authorization to Construct by: STEVE HEDRICK date 9-19-02

Installed by: TUCKER'S HAULING & GRADING

Operation Permit by: STEVE HEDRICK date 9-25-02

Existing System Inspection by: date

HEALTH DEPT. COPY WHITE OWNER COPY (FINAL) YELLOW OWNER COPY (INITIAL) PINK