CI

IREDELL COUNTY HEALTH DEPARTMENT

STATESVILLE 704-878-5305 MOORESVILLE 704-664-5281

IMPROVEMENT PERMIT / AUTHORIZATION TO CONSTRUCT / OPERATION PERMIT / EXISTING SYSTEM INSPECTION

PERMIT# 101244 PIN# 4752 44 9508 DATE 7/9/01

OWNER OR CONTRACTOR Lonnie Plyler PHONE: Business Home 704-871-9780

ADDRESS 650 Shiloh Rd Statesville NC 28677

LOCATION 70E, TR Shiloh turn at 650 Shiloh, go to the end of Drive

SUBDIVISION — BLOCK / SECTION — LOT — LOT AREA 50+AC SITE CLASS PS DESIGN FLOW 360 L.T.A.R. 0.5

Septic Tank: 1000 Gallons: STB 1012 Date 7-23-01
Pump Tank: Gallons: PT Date
Pump Make: Model Serial No.
Nitrification Field: No Fields 1 Square Feet 1200 Linear Feet 400
No Lines 4@100' Trench Width 36" Max Trench Bottom Depth 56" Gravel Depth 12"

☒ New System ☐ Repair System Type: I, II, III, IV, V, VI
System Description: Gravity Conventional
Repair System Description: Same
Maintenance Agreement Required: ☐ Yes ☐ No


☐ House/Mod. Home ☒ Mobile Home ☐ Business ☐ Other
No. Bedrooms 3 No. Bathrooms 2 No. Employees
☐ Slab ☐ Crawl Space ☐ Basement w/plumbing ☐ Basement wo/plumbing

Water Supply: ☒ Individual ☐ Public ☐ Community


Comments:/Conditions: Install lines on contour - Keep Well 100' from septic system - Remove any terraces in drain field Area

Comments:/Conditions: 9-14-01 CHANGED TANK LOCATION TO BACK + TO DROP BOXES IF INSTALLER WANTS TO USE.

INITIAL SITE SKETCH

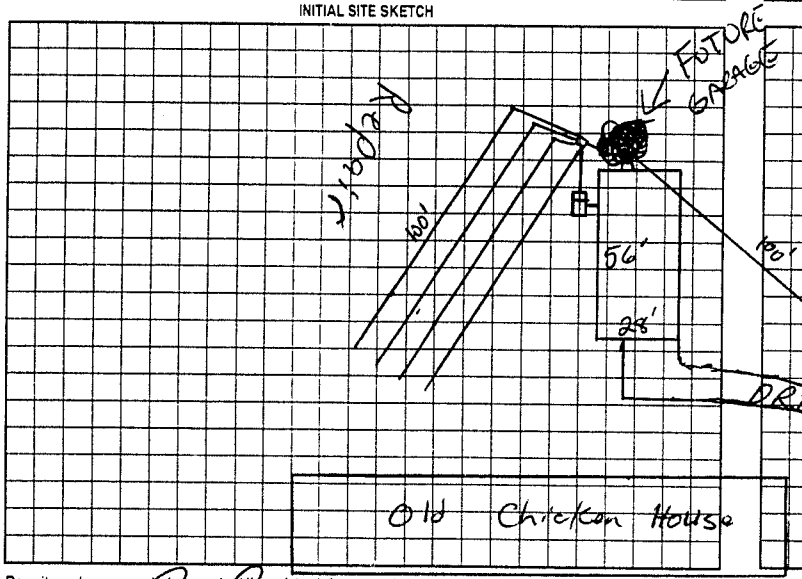

AS BUILT SKETCH

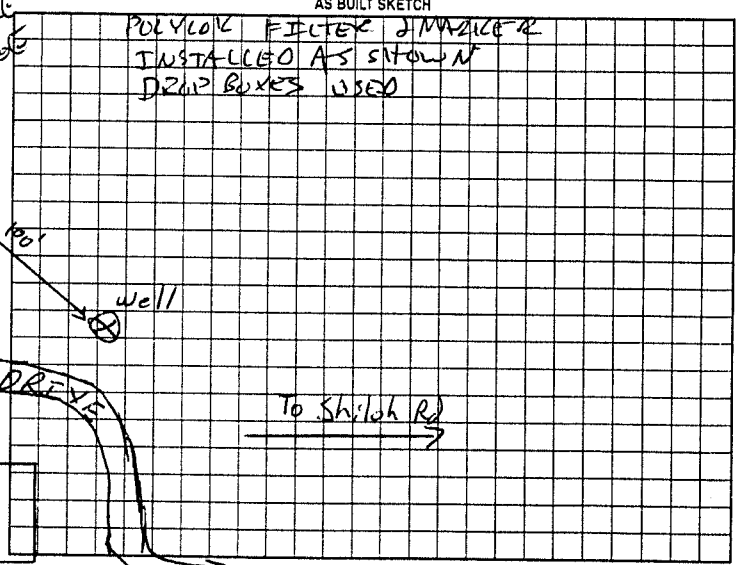

Permit can be suspended or revoked if any false information is supplied toward securing the permit/any unauthorized changes are made to the site/any unauthorized changes are made in the installation of the system. Improvement Permit with plat valid without expiration. Improvement Permit with site plan valid for sixty months. Authorization to Construct is valid for a period equal to that of Improvement Permit – not to exceed sixty months.

Signed: date 7-13-01 Installed by: Steve Jordan

Improvement Permit by: RSI date 7/9/01 Operation Permit by: KS date 10-18-01

Authorization to Construct by: RSI date 7/9/01 Existing System Inspection by: date

HEALTH DEPT COPY WHITE OWNER COPY (FINAL) YELLOW OWNER COPY (INITIAL) PINK