IREDELL COUNTY HEALTH DEPARTMENT

STATESVILLE 704-878-5305 MOORESVILLE 704-664-5281 (21)

IMPROVEMENT PERMIT / AUTHORIZATION TO CONSTRUCT / OPERATION PERMIT / EXISTING SYSTEM INSPECTION

PERMIT# 119315 PIN# 4752-51-6417 DATE 6-2-04

OWNER OR CONTRACTOR DAVID MILLSAPS PHONE: Business 704-873-1331 Home 704-902-4532

ADDRESS 1124 RADIO ROAD, STATESVILLE, NC 28677

LOCATION US 70 EAST, TR SMITH ROAD, TR FLINTLOCK LANE, 2ND MH LOT ON LEFT

SUBDIVISION FLINTLOCK MHP BLOCK / SECTION ____ LOT 5 LOT AREA 10.5 ACRES SITE CLASS. PS' DESIGN FLOW 360 L.T.A.R. EXISTING

Septic Tank: EXISTING Gallons; STB ____ Date ____

Pump Tank: ____ Gallons; PT ____ Date ____

Pump Make: ____ Model ____ Serial No. ____

Nitrification Field: No Fields 1 Square Feet ____ Linear Feet EXISTING

No Lines ____ Trench Width ____ Max Trench Bottom Depth ____ Gravel Depth ____

☐ New System ☐ Repair System Type: I, (II), III, IV, V, VI

System Description: CONVENTIONAL, GRAVITY

Repair System Description: ____

Maintenance Agreement Required: ☐ Yes ☒ No

☐ Slab ☒ Crawl Space ☐ Basement w/plumbing ☐ Basement wo/plumbing

☐ House/Mod. Home No. Bedrooms 3

☒ Mobile Home No. Bathrooms 2

☐ Business No. Employees ____

☐ Other ____


Water Supply: ☐ Individual ☐ Public ☒ Community

Comments:/Conditions:

Comments:/Conditions: SYSTEM APPEARS TO BE UNDERSIZED ACCORDING TO TODAY'S STANDARDS.

INITIAL SITE SKETCH

AS BUILT SKETCH

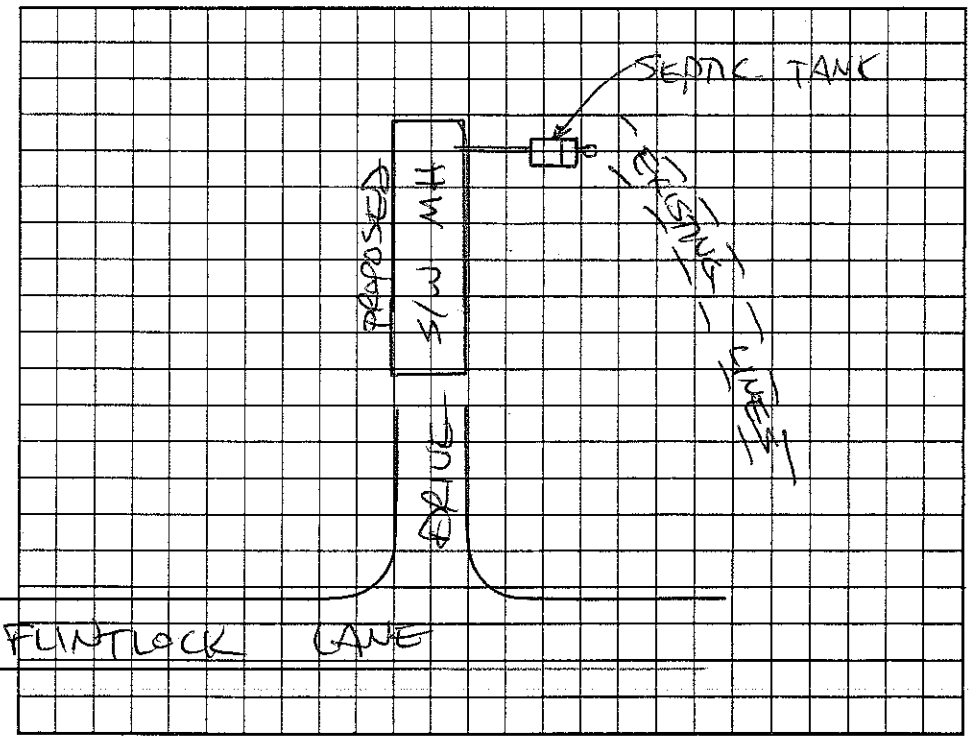

Permit can be suspended or revoked if any false information is supplied toward securing the permit/any unauthorized changes are made to the site/any unauthorized changes are made in the installation of the system. Improvement Permit with plat valid without expiration. Improvement Permit with site plan valid for sixty months. Authorization to Construct is valid for a period equal to that of Improvement Permit – not to exceed sixty months.

Signed: ____ date ____

Improvement Permit by: ____ date ____

Authorization to Construct by: ____ date ____

Installed by: ____

Operation Permit by: ____ date ____

Existing System Inspection by: STEVE HEDRICK date 6-2-04

HEALTH DEPT. COPY: WHITE OWNER COPY (FINAL): YELLOW OWNER COPY (INITIAL): PINK