IREDELL COUNTY HEALTH DEPARTMENT

STATESVILLE 704-878-5305 MOORESVILLE 704-664-5281

IMPROVEMENT PERMIT / AUTHORIZATION TO CONSTRUCT / OPERATION PERMIT / EXISTING SYSTEM INSPECTION

PERMIT# ~~FF1421359866~~ PIN# ~~4752516417~~ 4752516417 DATE 7-21-05

OWNER OR CONTRACTOR ~~Robert~~ DAVID Miltgaps PHONE: Business 704-872-1568 Home

ADDRESS 1124 Radio RD Statesville NC 28625

LOCATION Amity Hill RD (L) Shiloh RD (R) Flintlock 3RD ~~3RD~~ lot on Right

SUBDIVISION BLOCK / SECTION LOT LOT AREA SITE CLASS. IS DESIGN FLOW 360 L.T.A.R. 1.3

Septic Tank: 1000 Gallons; STB Date

Pump Tank: Gallons; PT Date

Pump Make: Model Serial No.

Nitrification Field: No Fields Square Feet 1740 Linear Feet 240

No Lines 3 Trench Width 36 Max Trench Bottom Depth 24 Gravel Depth 12

☐ New System ☐ Repair System Type: I, II, III, IV, V, VI

System Description: Convent. Gravity

Repair System Description:

Maintenance Agreement Required: ☐ Yes ☐ No

☐ House/Mod. Home No. Bedrooms 3

☐ Mobile Home No. Bathrooms 2

☐ Business No. Employees

☐ Other

☐ Slab ☐ Crawl Space ☐ Basement w/plumbing ☐ Basement wo/plumbing

Water Supply:
☐ Individual
☐ Public
☐ Community

Comments:/Conditions:


INITIAL SITE SKETCH


Comments:/Conditions:

all lines dry

1 year since used

AS BUILT SKETCH

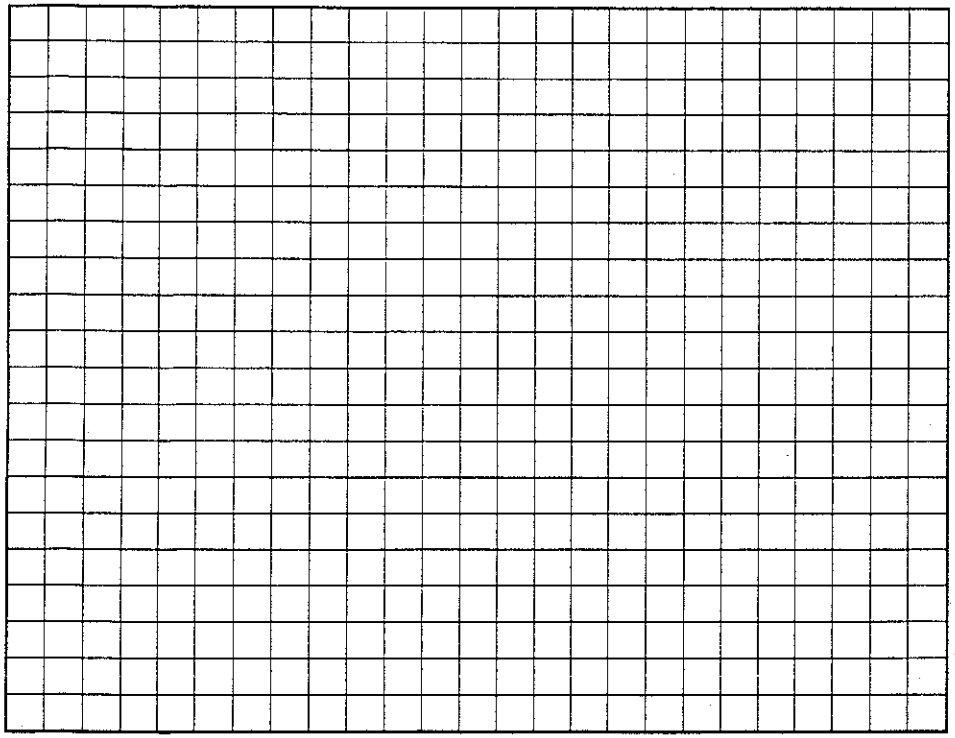

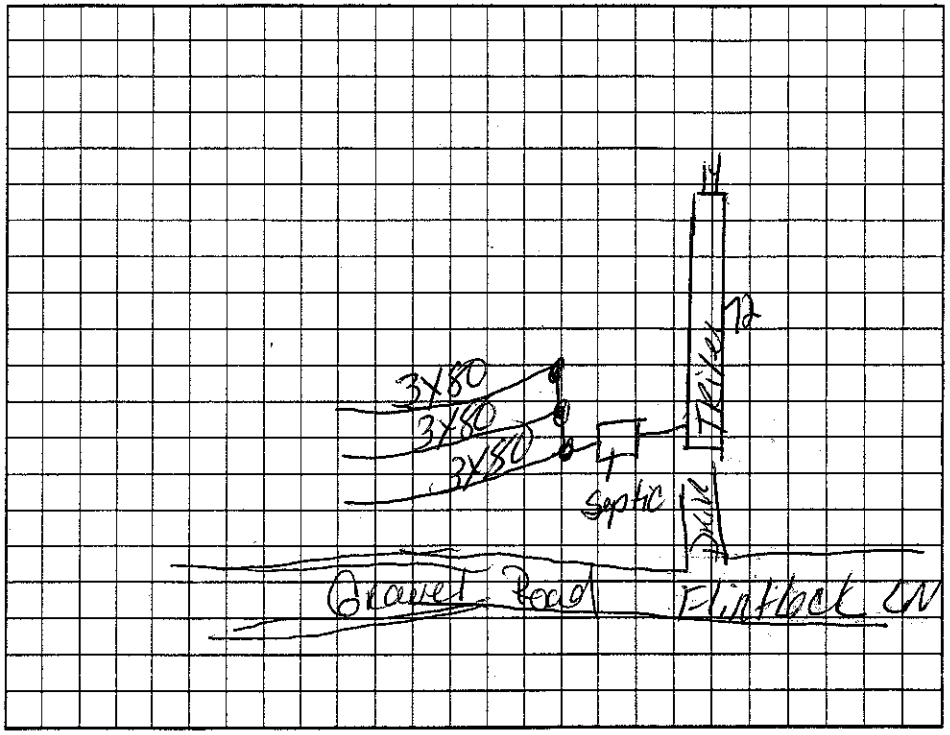

Permit can be suspended or revoked if any false information is supplied toward securing the permit/any unauthorized changes are made to the site/any unauthorized changes are made in the installation of the system. Improvement Permit with plat valid without expiration. Improvement Permit with site plan valid for sixty months. Authorization to Construct is valid for a period equal to that of Improvement Permit – not to exceed sixty months.

Signed: date

Improvement Permit by: date

Authorization to Construct by: date

Installed by:

Operation Permit by: date

Existing System Inspection by: Keith Cook date 7-21-05

HEALTH DEPT. COPY: WHITE OWNER COPY (FINAL): YELLOW OWNER COPY (INITIAL): PINK